

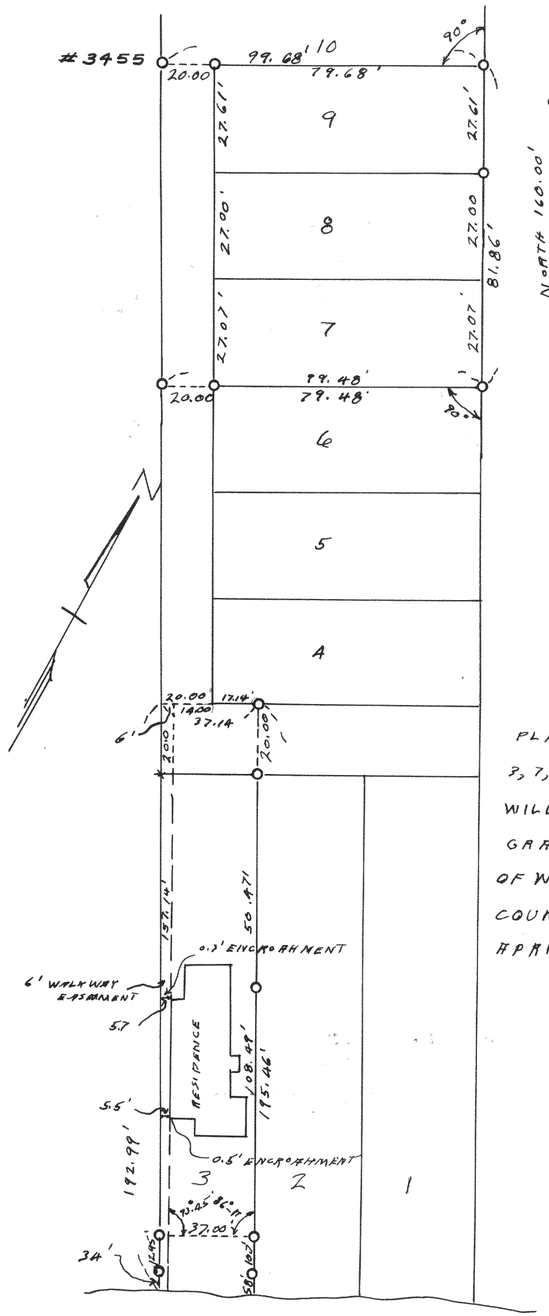


PLAT OF SURVEY OF LOTS 3, 7, 8 AND 9 IN WILLIAM G. WILLIAMSON'S SUB. OF LOT 7 GRAND TERRACE SUB., VILLAGE OF WILLIAMS BAY, WALWORTH COUNTY, WISCONSIN
APRIL 57 LLOYD L. JENSEN
COUNTY SURVEYOR

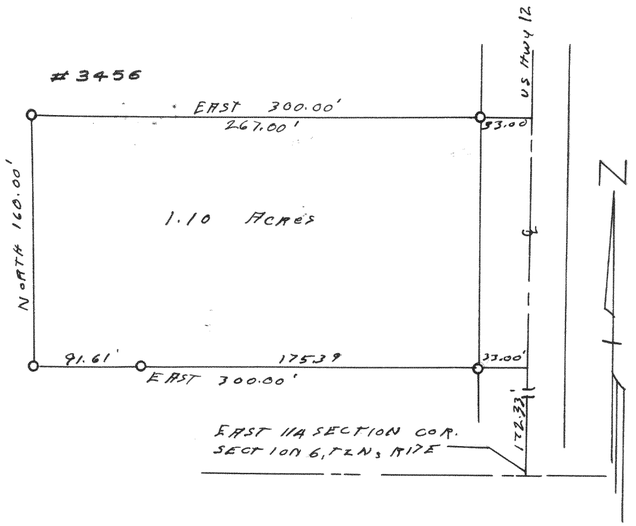

PLAT OF SURVEY OF A PARCEL OF LAND IN THE NW 1/4 OF SEC. 6, T2N, R17E WALWORTH COUNTY WISCONSIN
FEB 58 LLOYD L. JENSEN
COUNTY SURVEYOR

PLAT OF SURVEY OF OUT LOTS 86 & 87 LOCATED IN THE SOUTH WEST 1/4 OF SECTION 22, T1N, R16E, VILLAGE OF WALWORTH, WALWORTH COUNTY, WISCONSIN
MARCH 58 LLOYD L. JENSEN
COUNTY SURVEYOR

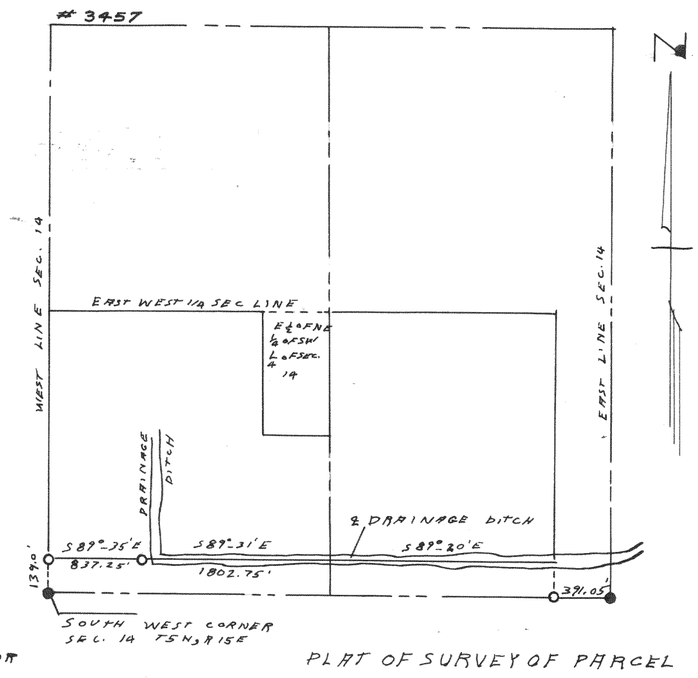

PLAT OF SURVEY OF PARCEL OF LAND LOCATED IN THE S 1/2 OF SECTION 14 T5N, R15E JEFFERSON COUNTY, WISCONSIN
MARCH 58 LLOYD L. JENSEN
COUNTY SURVEYOR

