

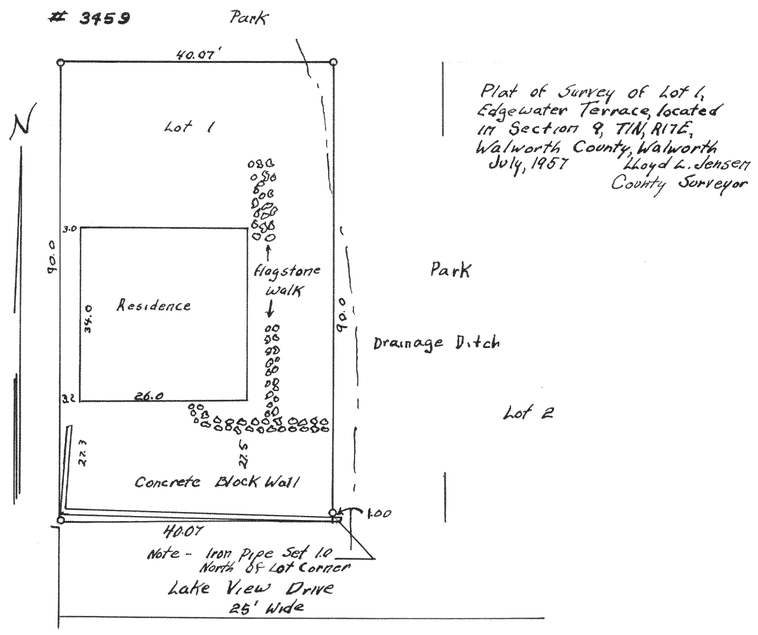



Plat of Survey of Lot 1, Edgewater Terrace, located in Section 9, T1N, R17E, Walworth County, Walworth July, 1957 Lloyd L. Jensen County Surveyor

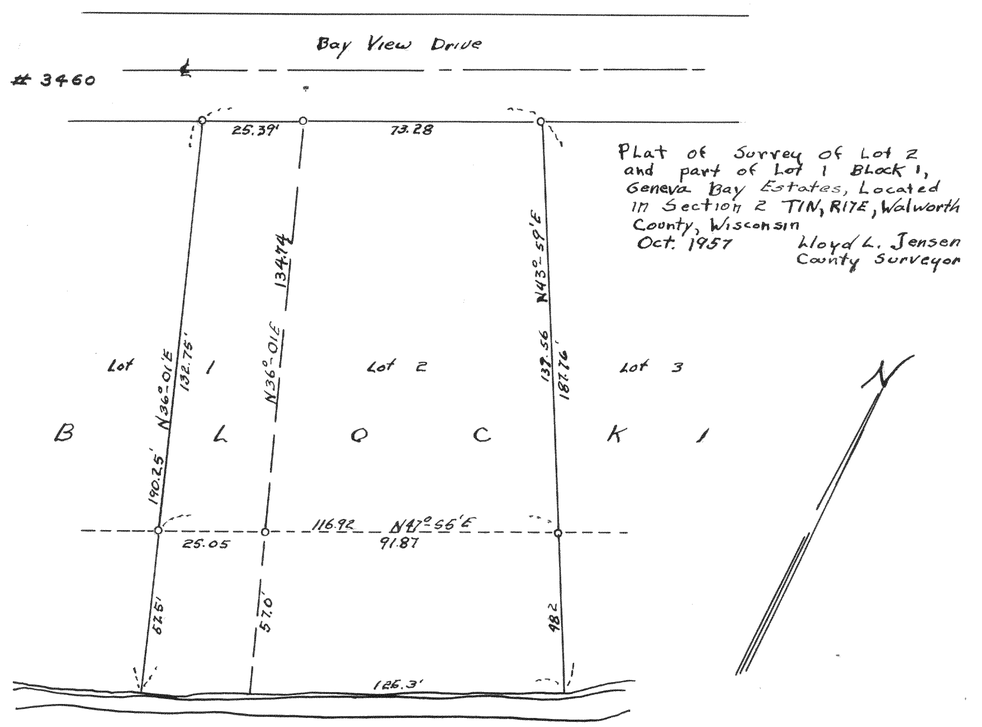

Plat of Survey of Lot 2 and part of Lot 1 Block 1, Geneva Bay Estates, Located in Section 2 T1N, R17E, Walworth County, Wisconsin Oct. 1957 Lloyd L. Jensen County Surveyor

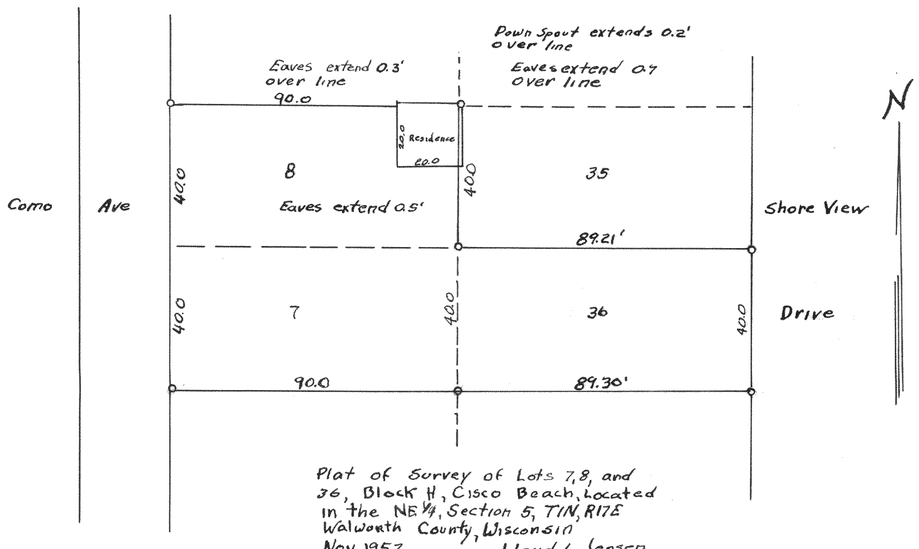

Plat of Survey of Lots 7, 8, and 36, Block H, Cisco Beach, Located in the NE¼, Section 5, T1N, R17E Walworth County, Wisconsin Nov. 1957 Lloyd L. Jensen County Surveyor

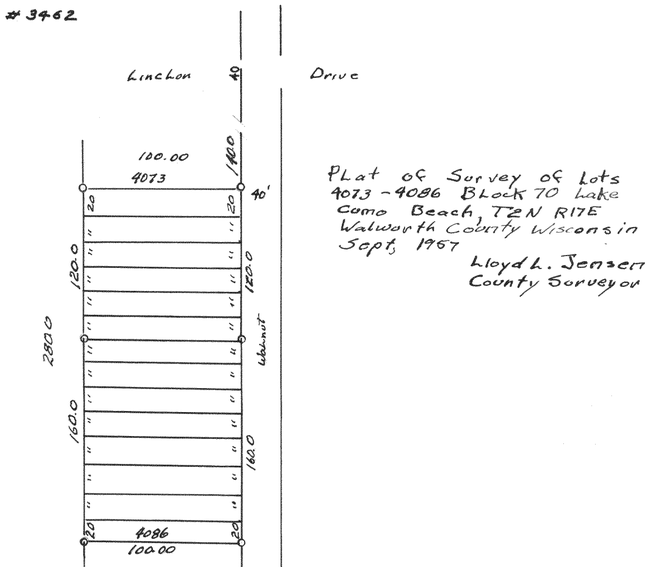

Plat of Survey of Lots 4073 - 4086 Block 70 Lake Como Beach, T2N R17E Walworth County Wisconsin Sept. 1957 Lloyd L. Jensen County Surveyor