
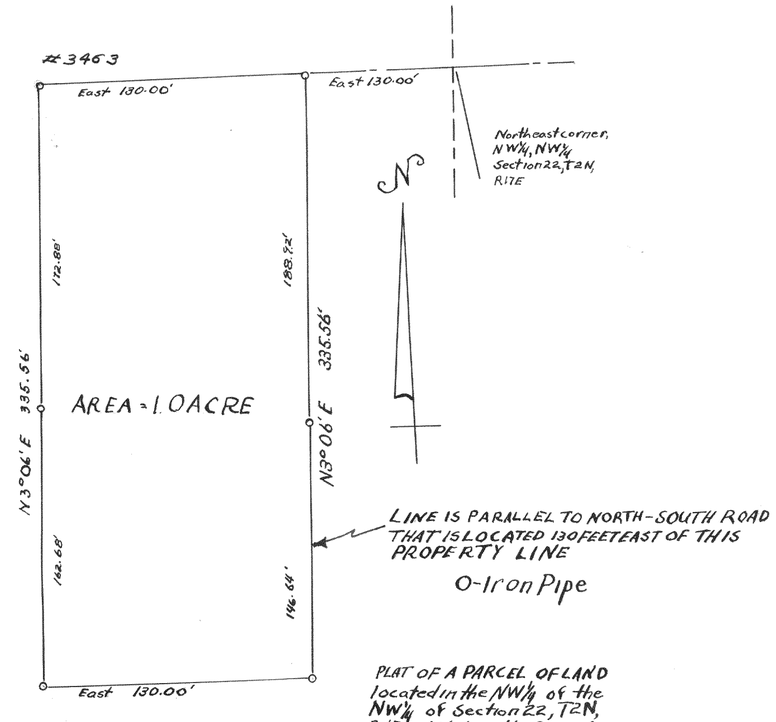



PLAT OF A PARCEL OF LAND located in the NW¼ of the NW¼ of Section 22, T2N, R17E, Walworth County, Wisconsin


NOV, 1957 Lloyd L. JENSEN SURVEYOR

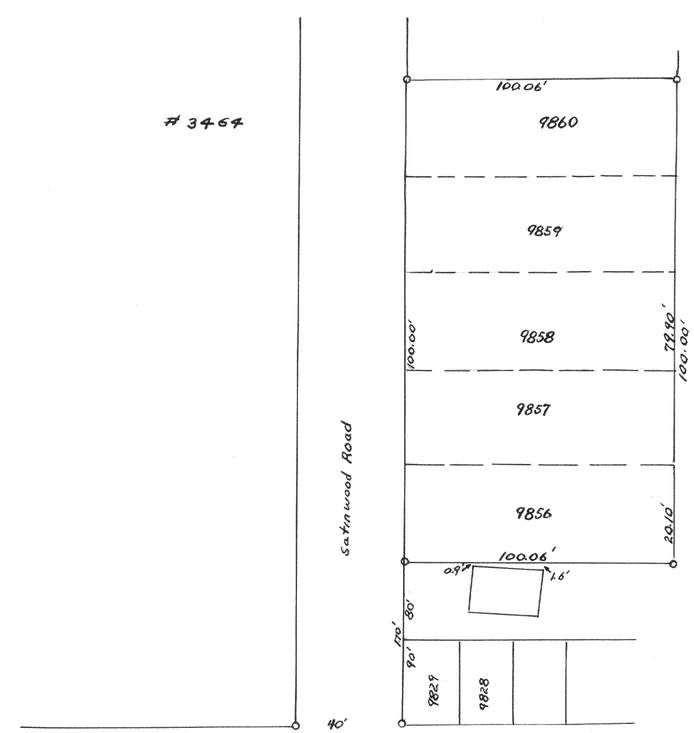

PLAT OF SURVEY
OF Lots 9856 To 9860 Lake Como Beach, Walworth County, Wisconsin
Sept, 1957

Lloyd L. Jensen
County Surveyor

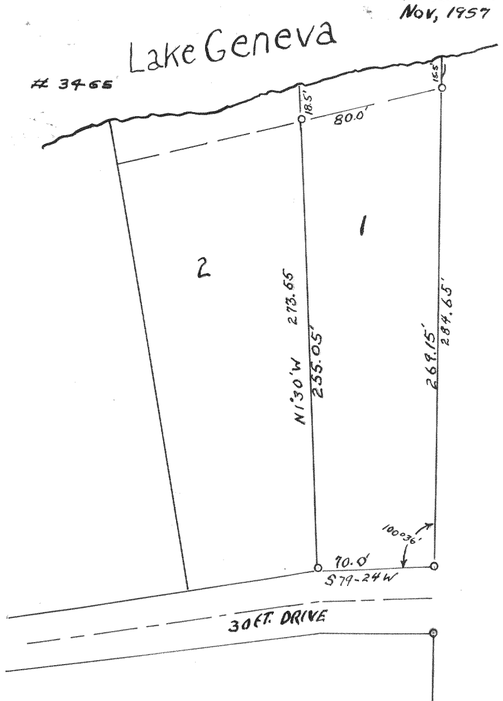


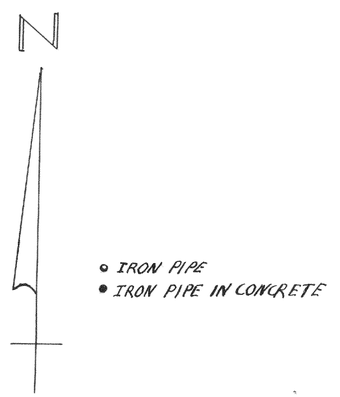

PLAT OF SURVEY OF
Lot 1 of the Birches First Addition, Located in Section 9, T1N R17E of Walworth County, Wisconsin
Nov, 1957

Lloyd L. Jensen
County Surveyor

Longfellow DRIVE

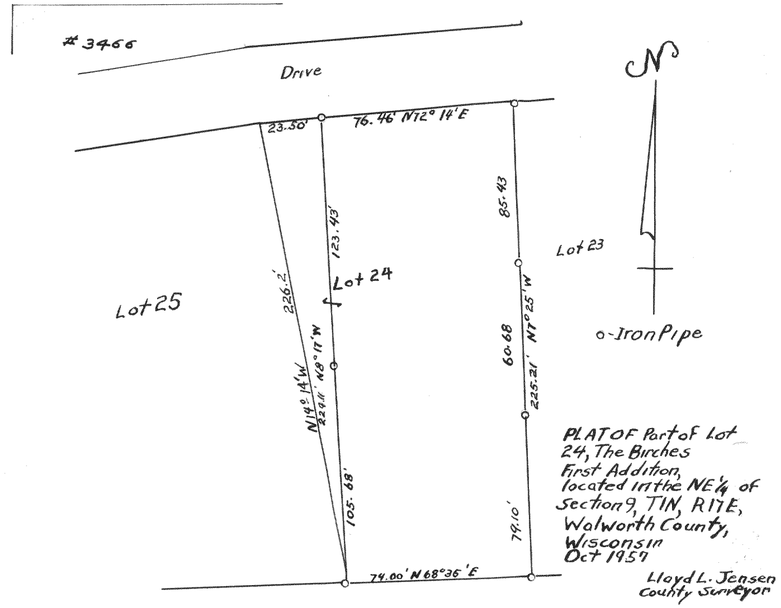

PLAT OF Part of Lot 24, The Birches First Addition, located in the NE¼ of Section 9, T1N, R17E, Walworth County, Wisconsin
Oct 1957

Lloyd L. Jensen
County Surveyor