
3473

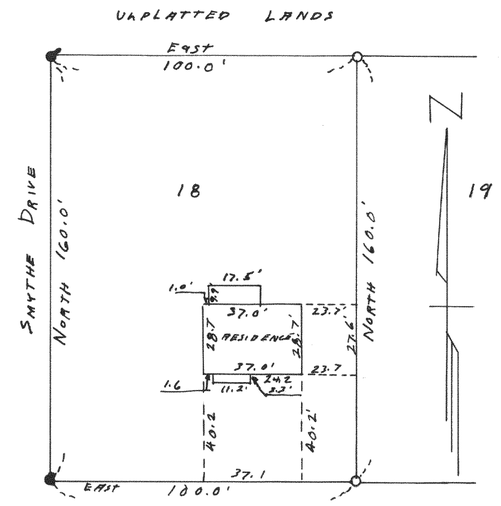


PLAT OF SURVEY OF LOT 18, BAY WOOD HEIGHTS SUBD. LOCATED IN THE NW 1/4 OF SEC. 1, T1N, R16E VILLAGE OF WILLIAMS BAY WALWORTH COUNTY, WISCONSIN MAR 1958

LLOYD L. JENSEN

COUNTY SURVEYOR

3474

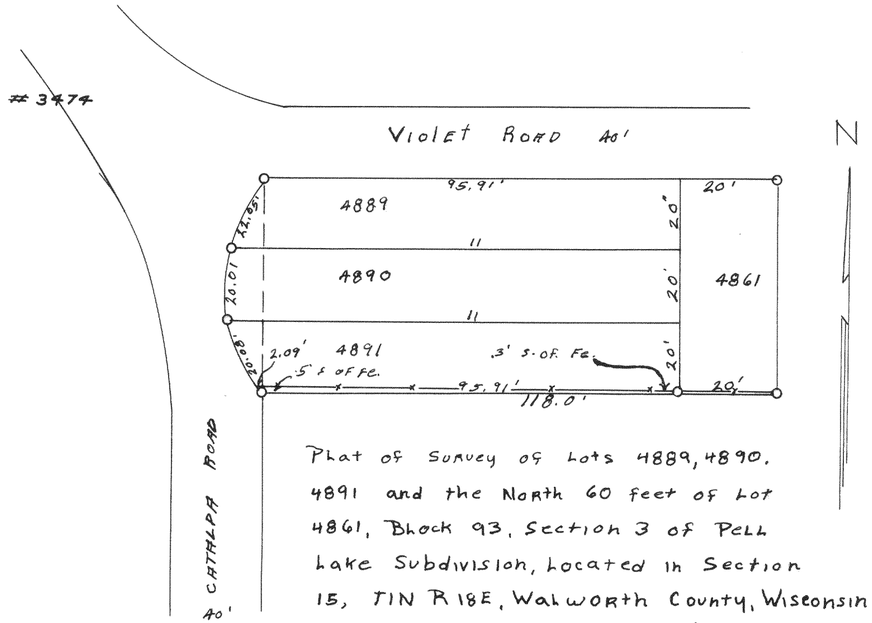


Plat of Survey of Lots 4889, 4890, 4891 and the North 60 feet of Lot 4861, Block 93, Section 3 of Pell Lake Subdivision, Located in Section 15, T1N R18E, Walworth County, Wisconsin

April, 1958 Lloyd L. Jensen

County Surveyor

3475

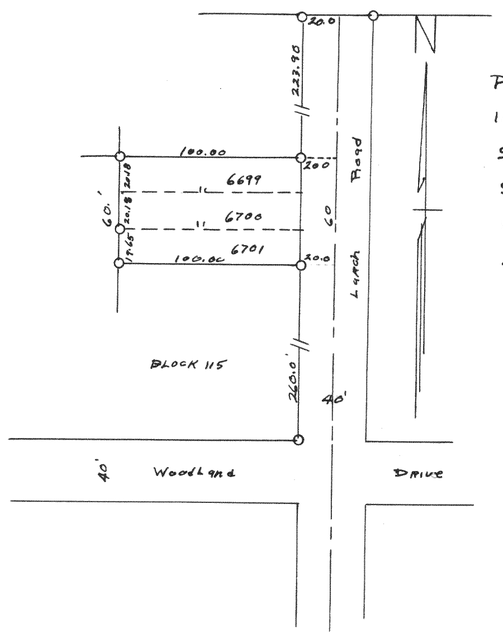


Plat of Survey of Lot 6699 to 6701, Inclusive, Block 115, Lake Como Beach Subdivision, Located in The NorthWest 1/4 Section 28, T2N, R17E, Walworth County, Wisconsin

April 21, 1958 Lloyd L Jensen

County Surveyor

3476

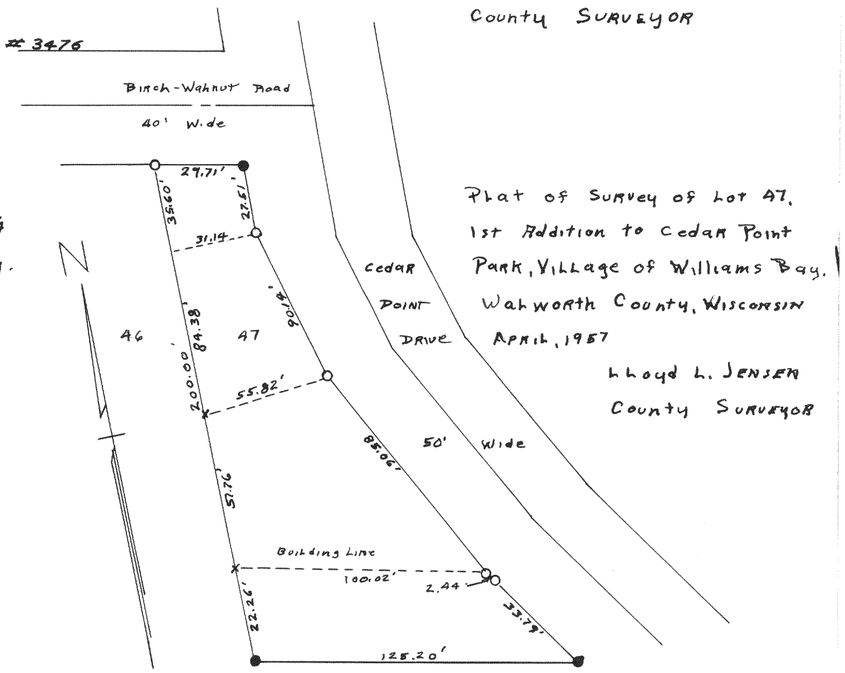

Plat of Survey of Lot 47, 1st Addition to Cedar Point Park, Village of Williams Bay, Walworth County, Wisconsin

April, 1957

Lloyd L. Jensen

County Surveyor