
2678

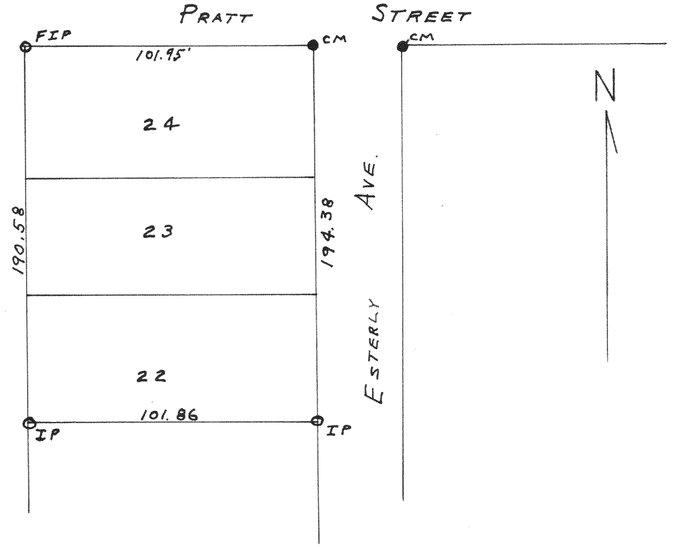


PLAT OF SURVEY OF LOTS 22, 23, & 24 OF BLOCK 2 OF FISH & JOHNSON'S ADDITION TO THE CITY OF WHITEWATER.

JUNE 30, 1952

Floyd L Jensen SA
COUNTY SURVEYOR

2679

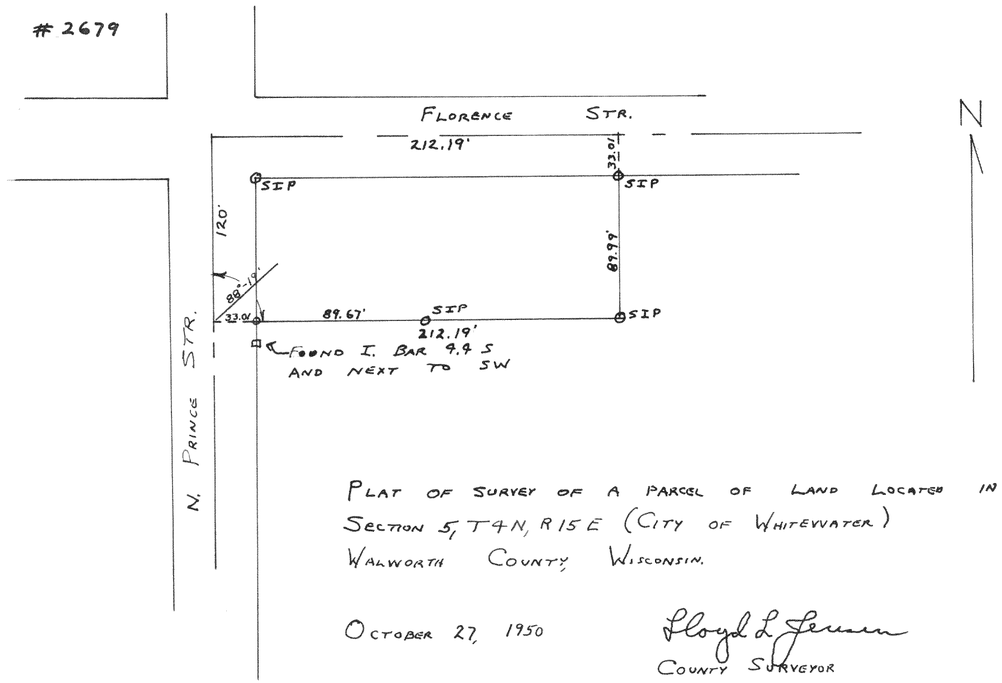


PLAT OF SURVEY OF A PARCEL OF LAND LOCATED IN SECTION 5, T4N, R15E (CITY OF WHITEWATER) WALWORTH COUNTY, WISCONSIN.

OCTOBER 27, 1950

Floyd L Jensen
COUNTY SURVEYOR

2680

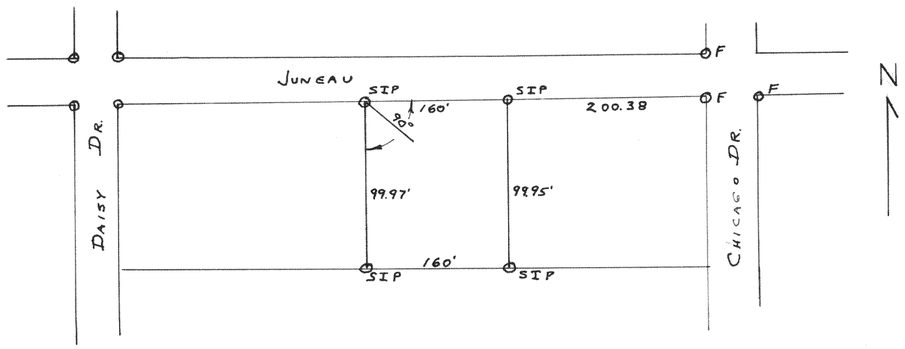


PLAT OF SURVEY OF LOTS 442 TO 449 BLOCK 8 OF PELL LAKE ADDITION

AUGUST 2, 1952

Floyd L Jensen SA
COUNTY SURVEYOR

2681

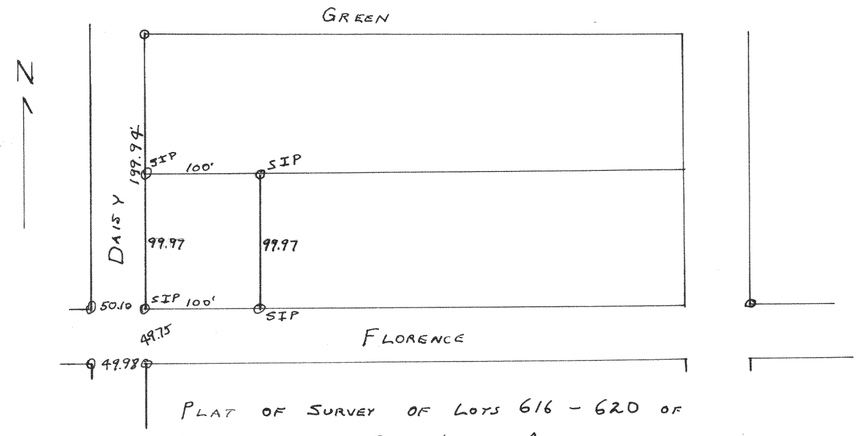

PLAT OF SURVEY OF LOTS 616 - 620 OF BLOCK 10 OF PELL LAKE ADDITION.

AUGUST 2, 1952

Floyd L Jensen
COUNTY SURVEYOR