


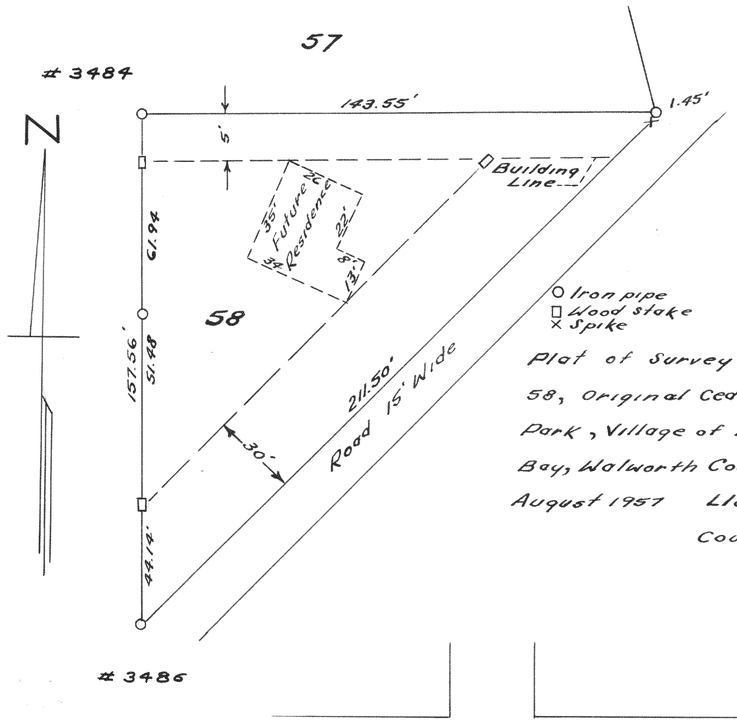


Plat of Survey of lot 58, Original Cedar Point Park, Village of Williams Bay, Walworth County, Wisconsin.
August 1957 Lloyd L. Jensen
County Surveyor

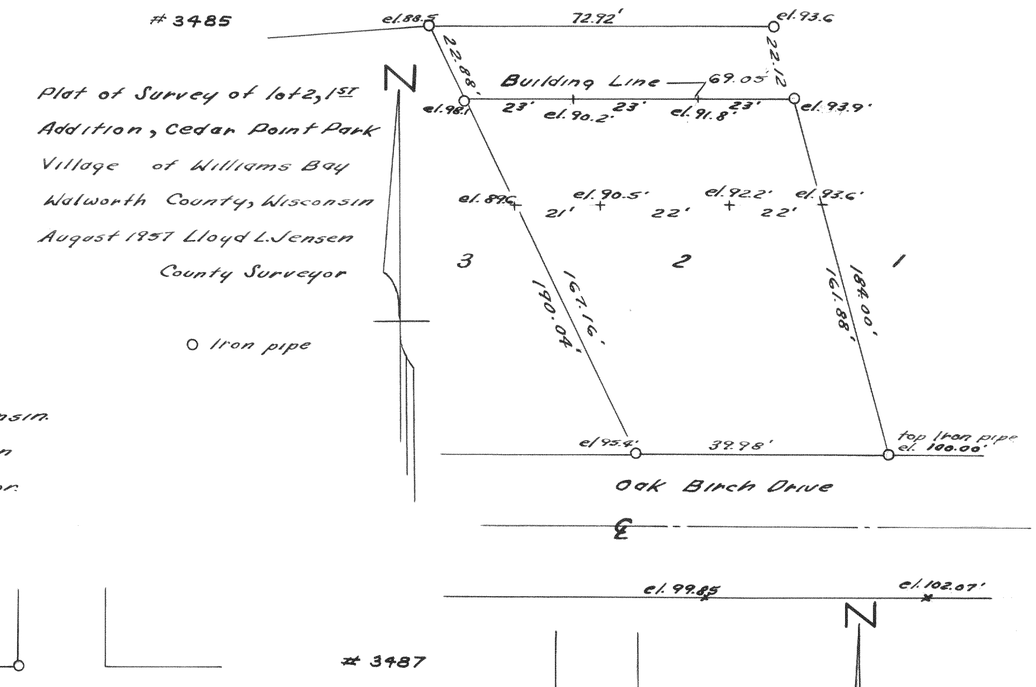


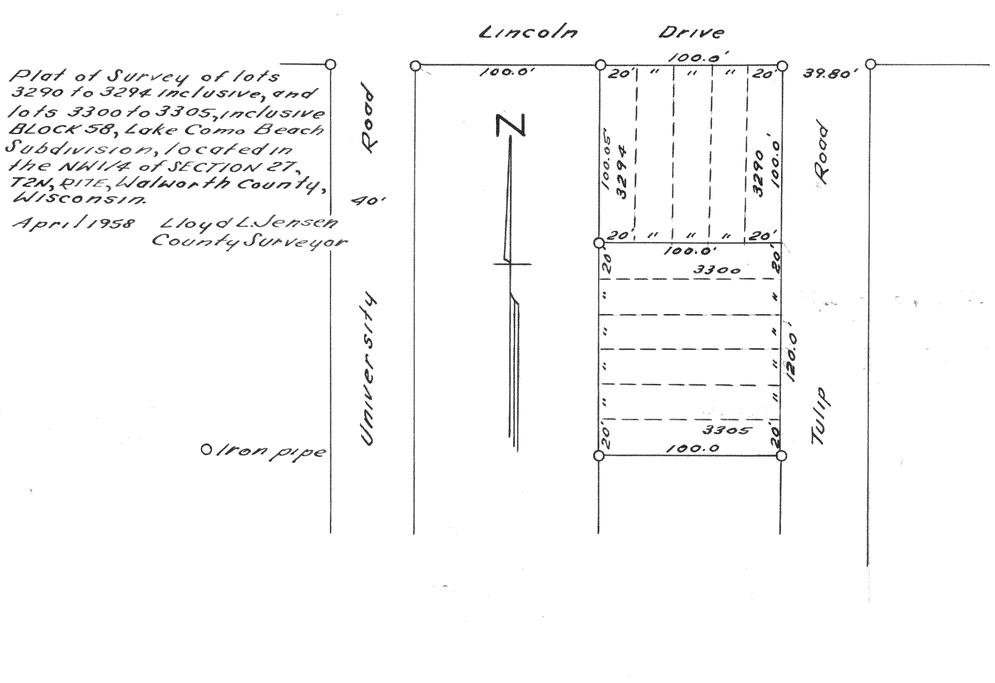

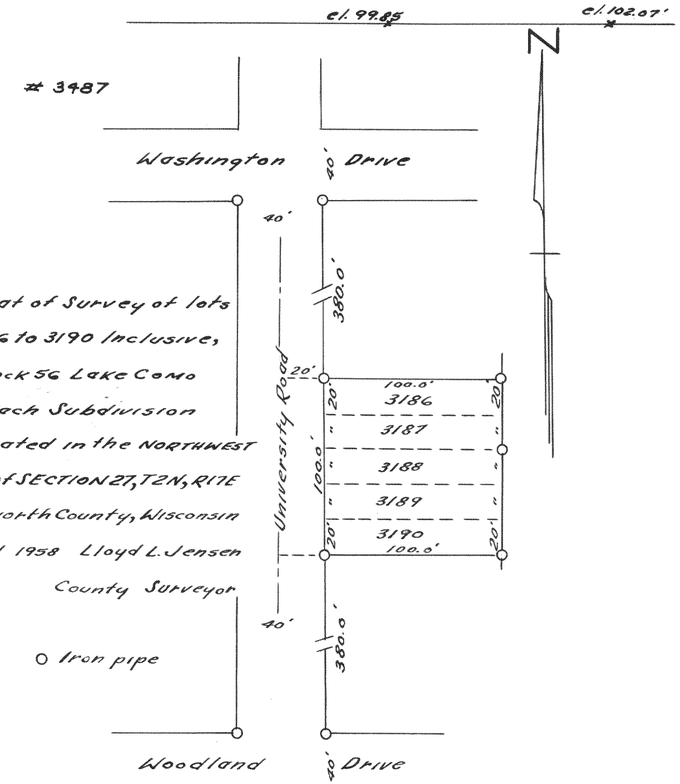

Plat of Survey of lots 3186 to 3190 Inclusive, Block 56 Lake Como Beach Subdivision Located in the NORTHWEST 1/4 of SECTION 27, T2N, R17E Walworth County, Wisconsin
April 1958 Lloyd L. Jensen
County Surveyor

Iron pipe