

3493

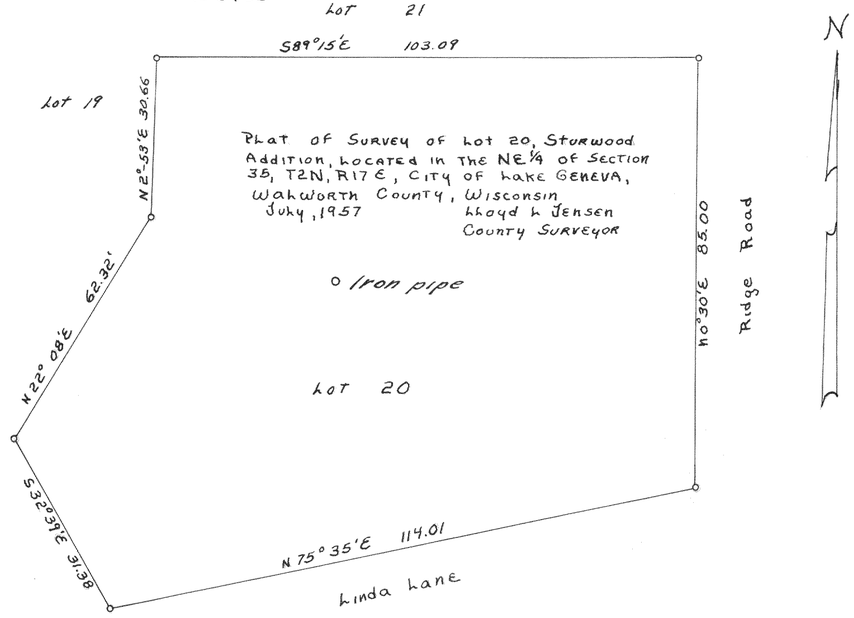


3494

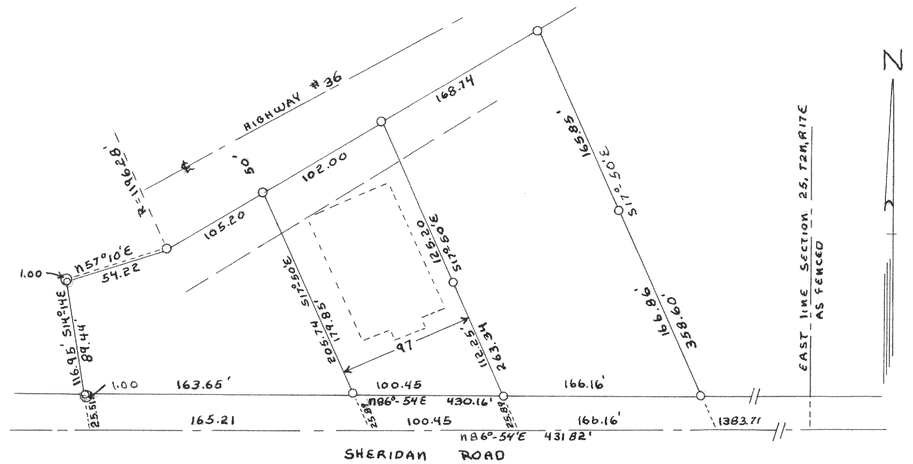


Plat of Survey of Parcel of Land located in the NE¼ of Section 25, T2N, R17E, City of Lake Geneva, Walworth County Wisconsin
May 1957
Revised Dec. 18, 1957
Lloyd L Jensen
County Surveyor

3495

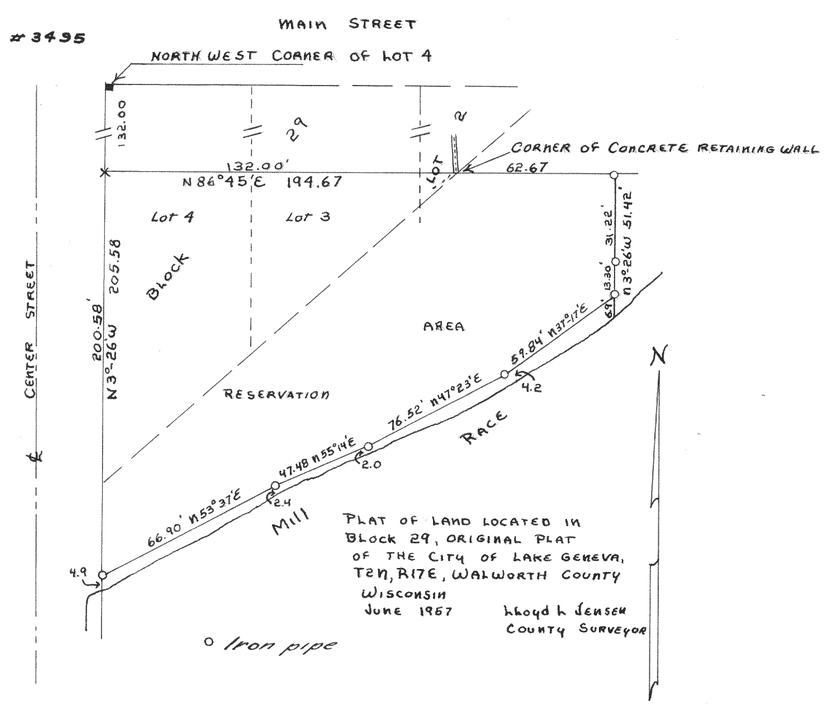

3496

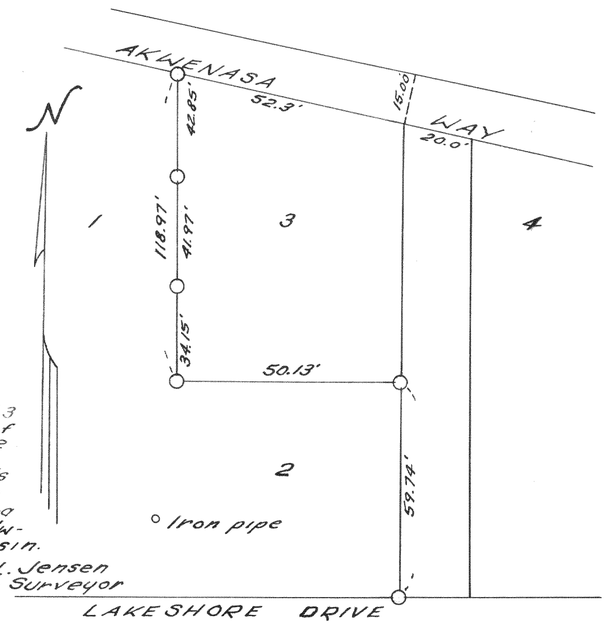

Plat of Survey of Lot 3 and the west 20 feet of Lot 4 (measured) on the front line thereof, of Block 4 of Indian Hills Subdivision, located in the Village of Fontana on Lake Geneva, Walworth County, Wisconsin.
July 1958
Lloyd L. Jensen
County Surveyor