

3507

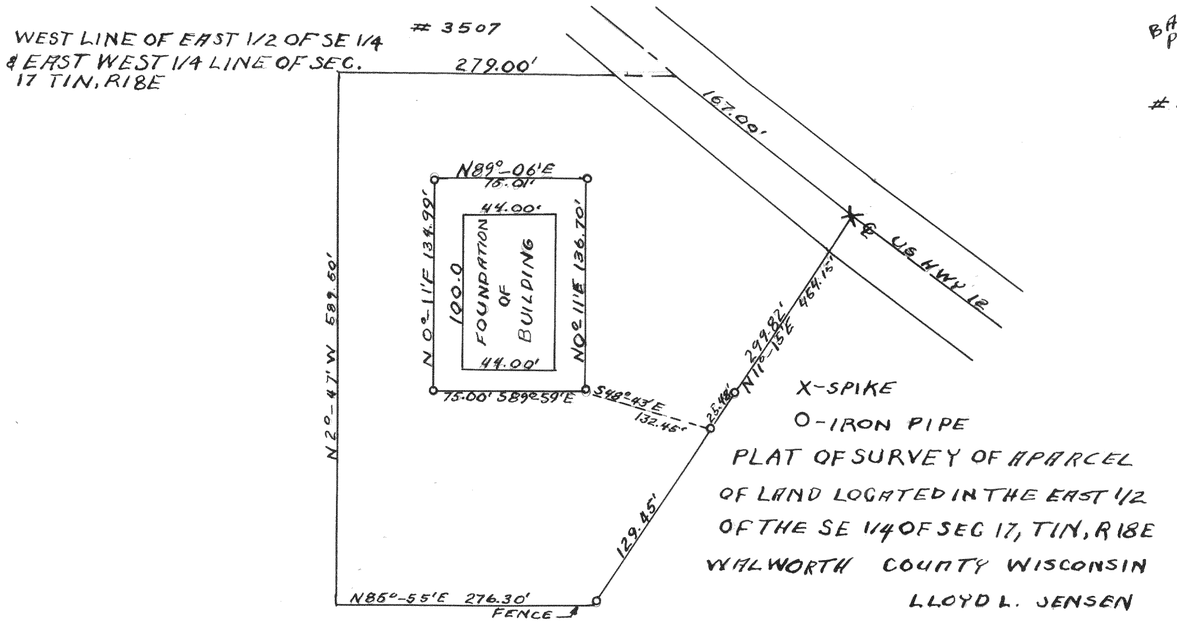

PLAT OF SURVEY OF A PARCEL OF LAND LOCATED IN THE EAST 1/2 OF THE SE 1/4 OF SEC 17, T1N, R18E WALWORTH COUNTY WISCONSIN

LLOYD L. JENSEN
COUNTY SURVEYOR

3508

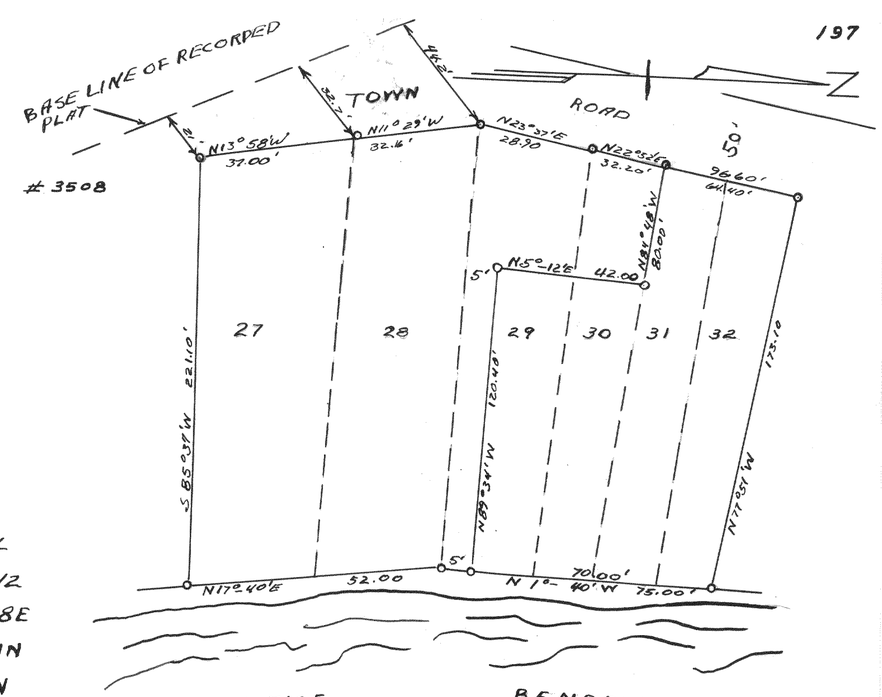


BENEDICT

Plat of Survey of Lots 27, 28, 29, 30, 31, and 32 of Block I Skinner's 8th Addition to Nippersink Park in the NE¼ of Section 24, T1N, R18E, Walworth County, Wisconsin
July, 1957

Lloyd L. Jensen
County Surveyor

O- Iron Pipe

3509

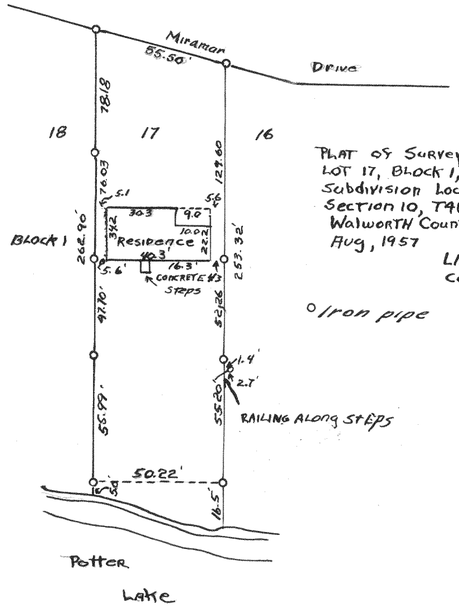


PLAT OF SURVEY OF LOT 17, BLOCK 1, MIRAMAR SUBDIVISION LOCATED IN SECTION 10, T4N, R18E WALWORTH COUNTY, WISCONSIN
AUG, 1957

Lloyd L. Jensen
County Surveyor

O Iron pipe

3510

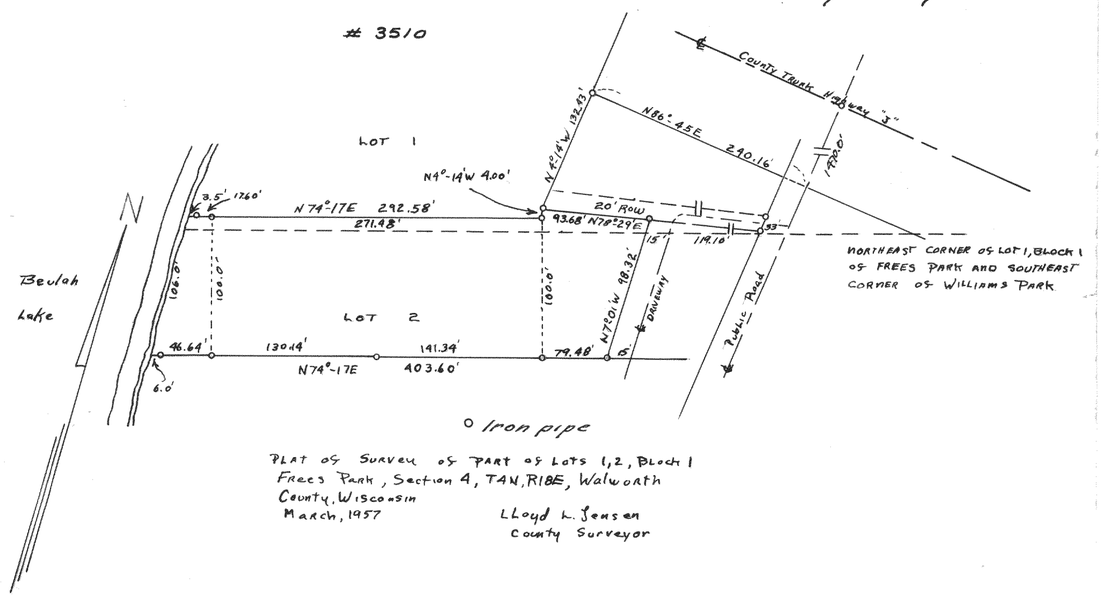

O Iron pipe

PLAT OF SURVEY OF PART OF LOTS 1, 2, BLOCK 1 FREES PARK, SECTION 4, T4N, R18E, WALWORTH COUNTY, WISCONSIN
MARCH, 1957

LLoyd L. Jensen
County Surveyor