
#2682

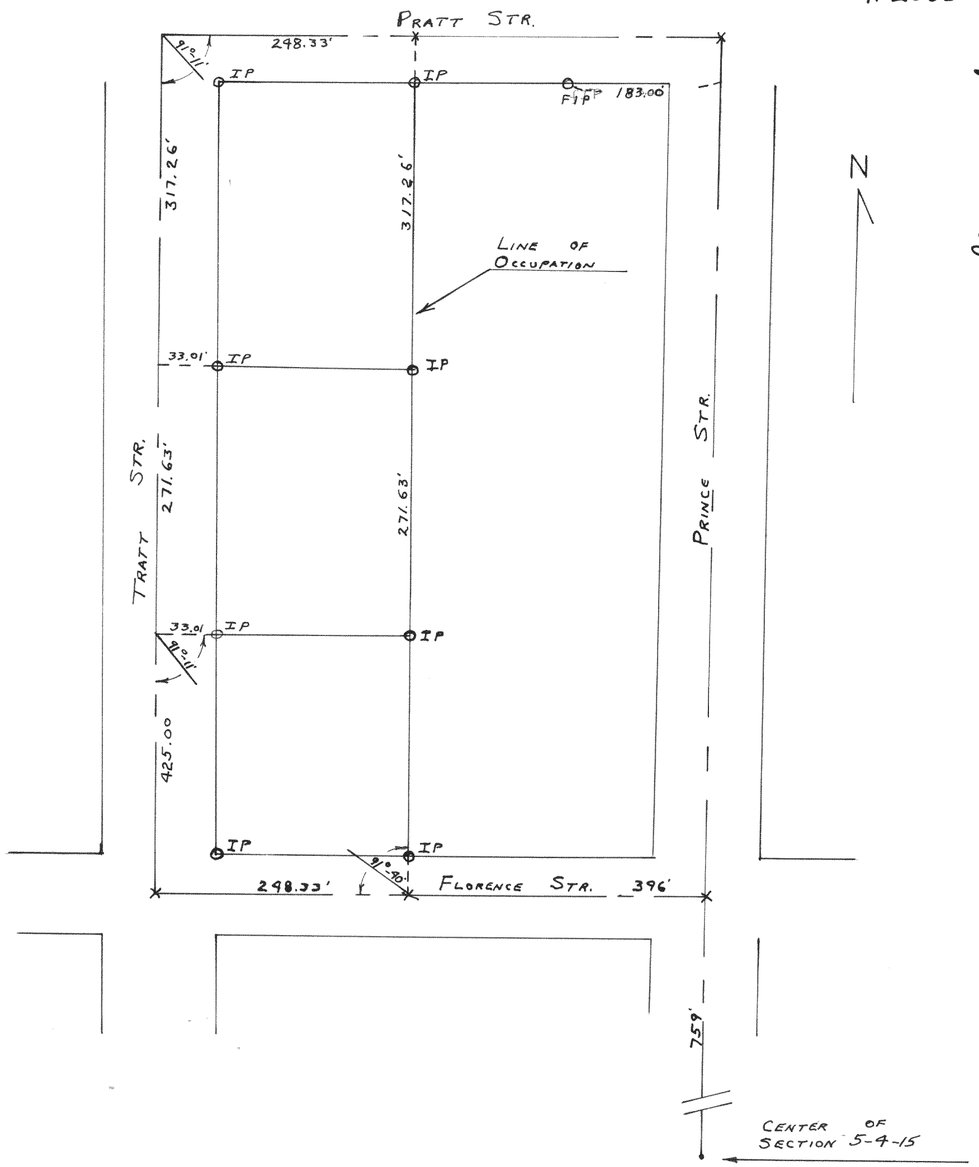

PLAT OF SURVEY OF LAND LOCATED IN THE CITY OF WHITEWATER.

AUGUST 28, 1952

Lloyd L Jensen SA
COUNTY SURVEYOR

#2683

Plat of Lake Tombeau Woods Subdivision, Located in Section 24, T1N R18E.
Recorded in Vol 12 on Page 48+49 of Plats for Walworth County.

Sept. 12, 1951

Lloyd L. Jensen
County Surveyor