
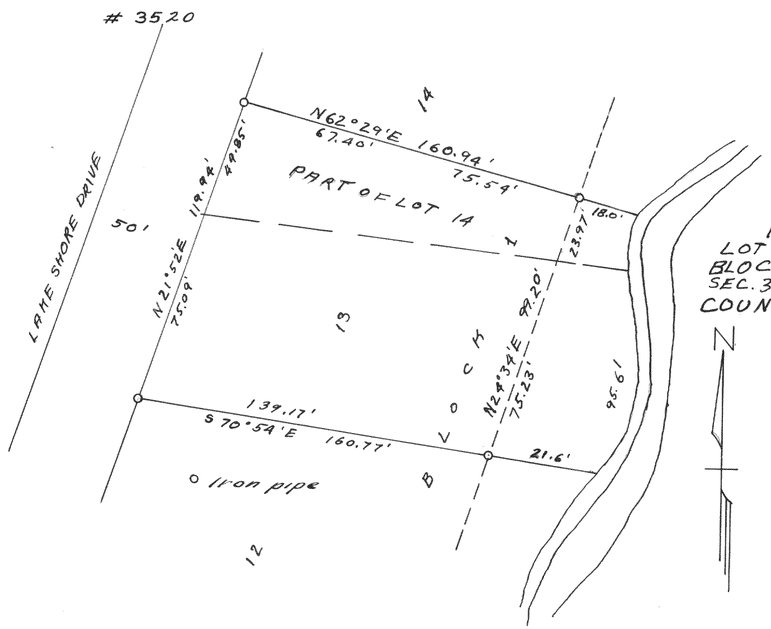



PLAT OF SURVEY OF LOT 13 AND PART OF LOT 14, BLOCK 1, MORAINE PARK SUBD. SEC. 34, T4N, R15E WALWORTH COUNTY WISCONSIN

LLOYD L. JENSEN
COUNTY SURVEYOR

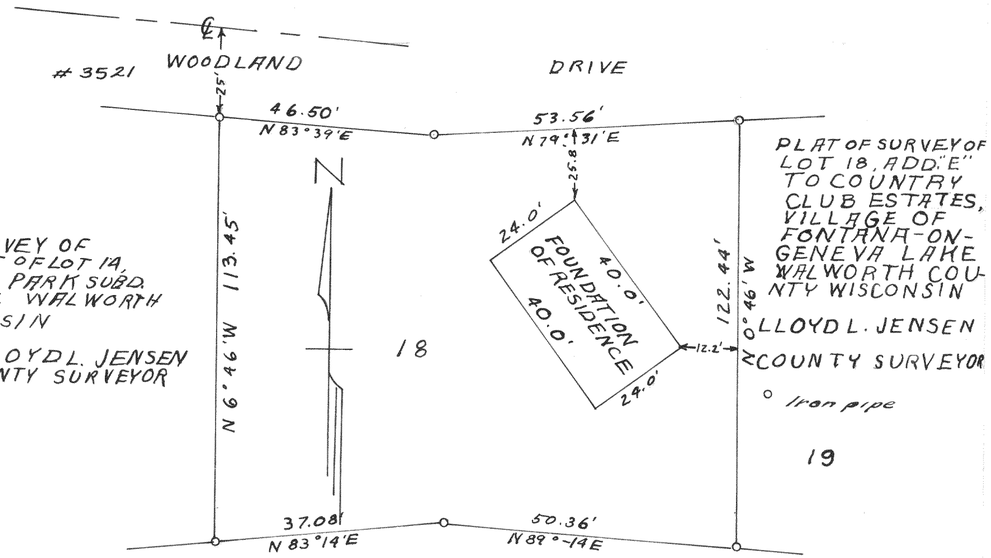


PLAT OF SURVEY OF LOT 18, ADD. "E" TO COUNTRY CLUB ESTATES, VILLAGE OF FONTANA-ON-GENEVA LAKE WALWORTH COUNTY WISCONSIN

LLOYD L. JENSEN
COUNTY SURVEYOR

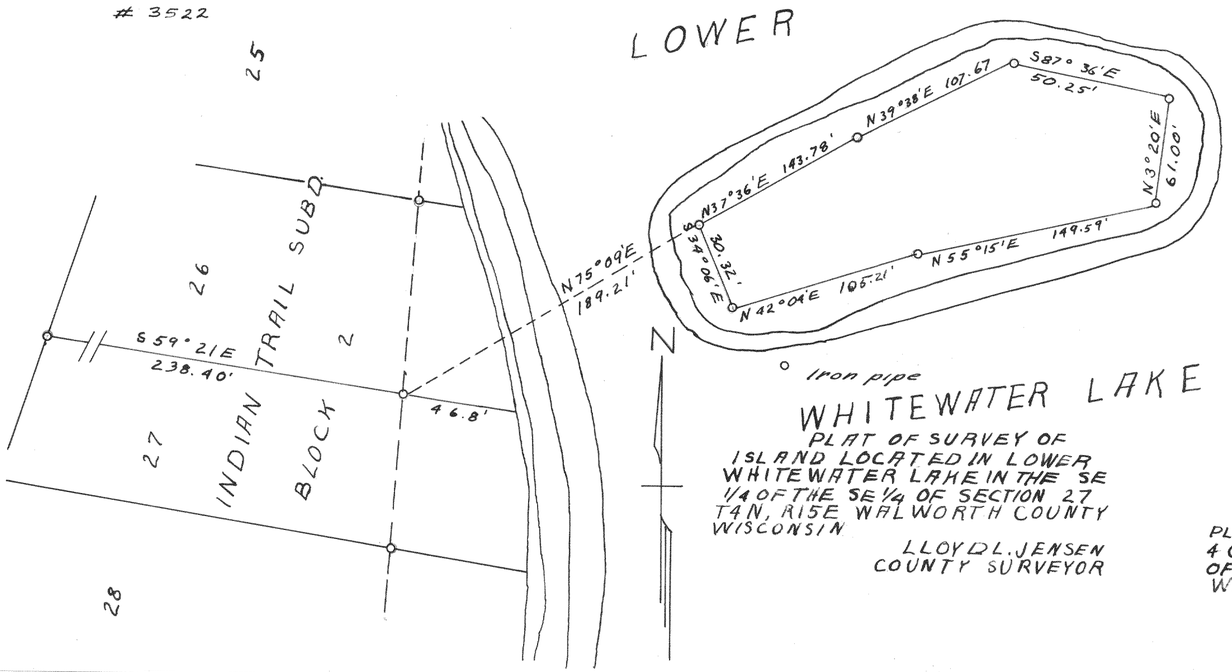

PLAT OF SURVEY OF ISLAND LOCATED IN LOWER WHITEWATER LAKE IN THE SE 1/4 OF THE SE 1/4 OF SECTION 27 T4N, R15E WALWORTH COUNTY WISCONSIN

LLOYD L. JENSEN
COUNTY SURVEYOR

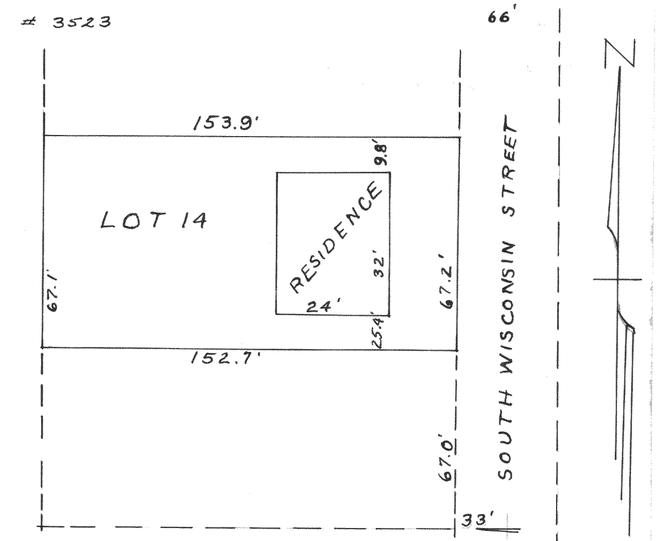

PLAT OF SURVEY OF LOT 14 OF BLOCK 4 OF PRESTON'S ADD. TO THE CITY OF ELKHORN, WALWORTH COUNTY WISCONSIN

LLOYD L. JENSEN
COUNTY SURVEYOR

EAST 1/4 SEC. CORNER OF SEC. 1, T2N, R16E