
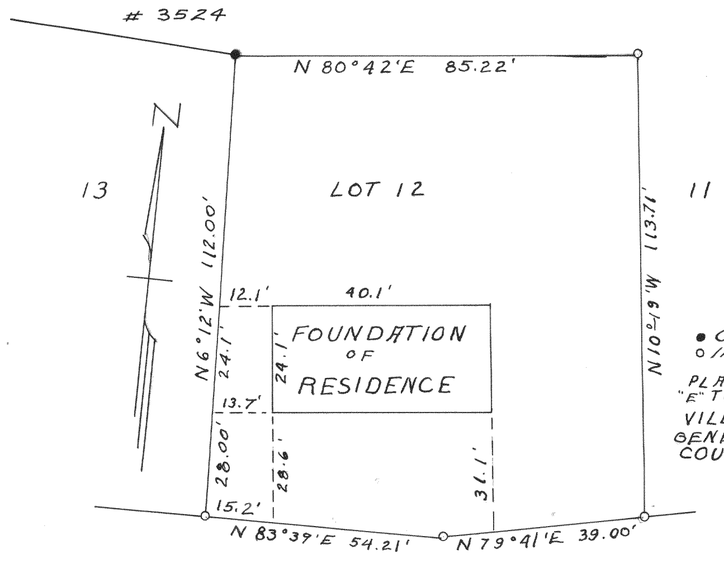


• Concrete monument
o Iron pipe

PLAT OF SURVEY OF LOT 12 ADD "E" TO COUNTRY CLUB ESTATES, VILLAGE OF FONTANA-ON-GENEVA LAKE WALWORTH COUNTY, WISCONSIN


LLOYD L. JENSEN
COUNTY SURVEYOR

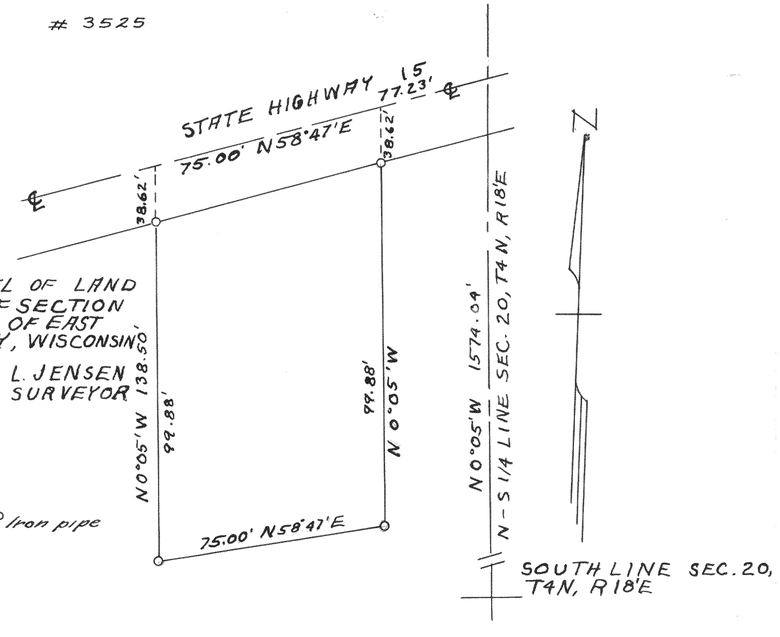

PLAT OF SURVEY OF A PARCEL OF LAND LOCATED IN THE SW 1/4 OF SECTION 20, T4N, R18E, VILLAGE OF EAST TROY, WALWORTH COUNTY, WISCONSIN

LLOYD L. JENSEN
COUNTY SURVEYOR

o Iron pipe

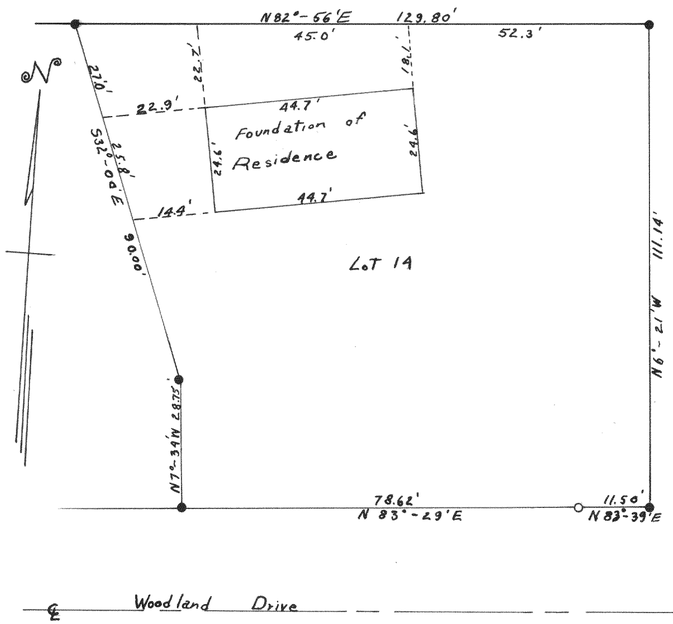


PLAT OF SURVEY OF LOT 14, ADD'N. "E" TO COUNTRY CLUB ESTATES, LOCATED IN SECTION 14, SECTION 23, T1N, R16E, VILLAGE OF FONTANA-ON-GENEVA LAKE, WALWORTH COUNTY, WISCONSIN

LLOYD L. JENSEN
COUNTY SURVEYOR

• Concrete monument
o Iron pipe

Timber Trail Drive

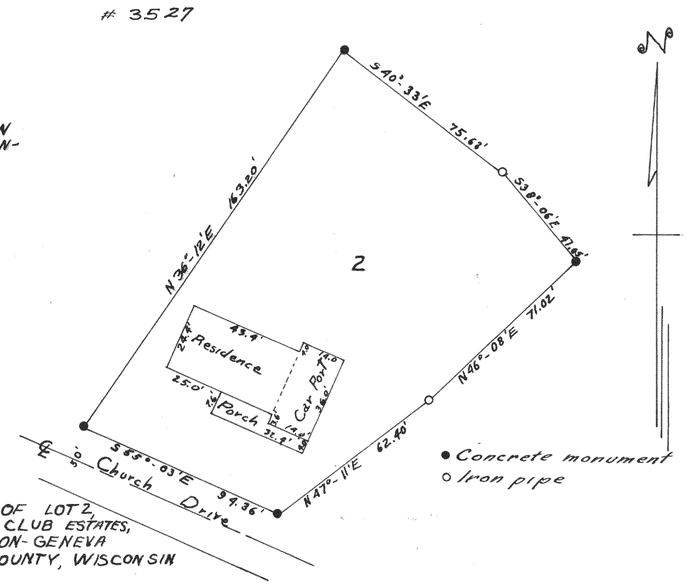

PLAT OF SURVEY OF LOT 2, ADD'N "C", COUNTRY CLUB ESTATES, VILLAGE OF FONTANA-ON-GENEVA LAKE, WALWORTH COUNTY, WISCONSIN

LLOYD L. JENSEN
COUNTY SURVEYOR

• Concrete monument
o Iron pipe