
3532


O-Iron Pipe
X-Spike
Dashed Figures from recorded descriptions

Plat of Survey of a parcel of land Located in the NW¼ of Section 6, T4N, R17E, Walworth County, Wisconsin July, 1957

Lloyd L. Jensen
County Surveyor

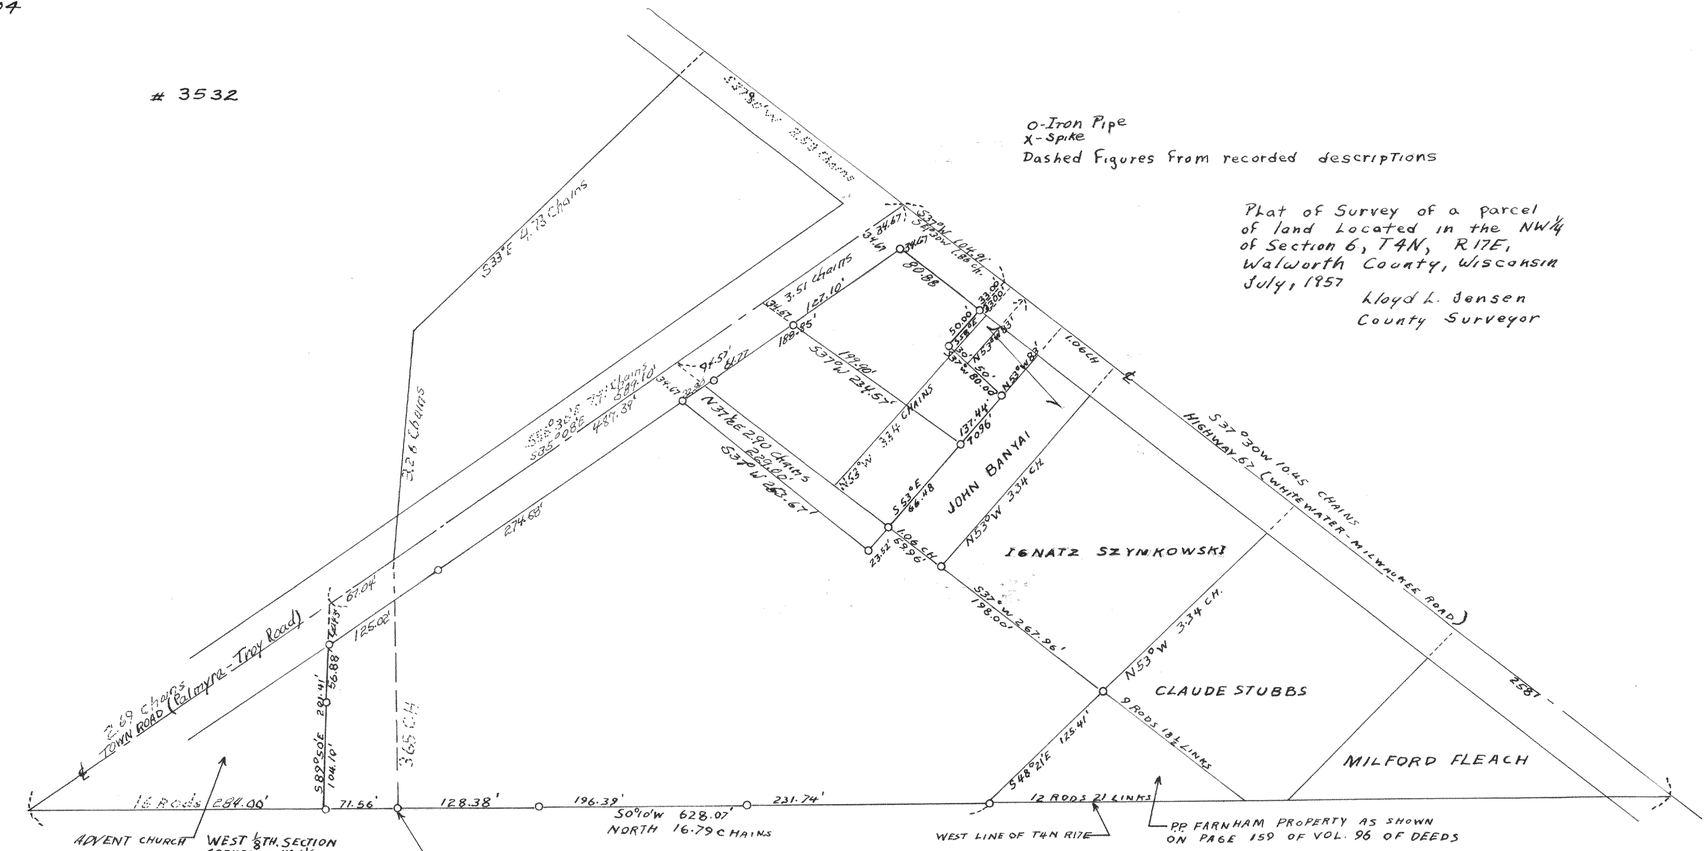

3533

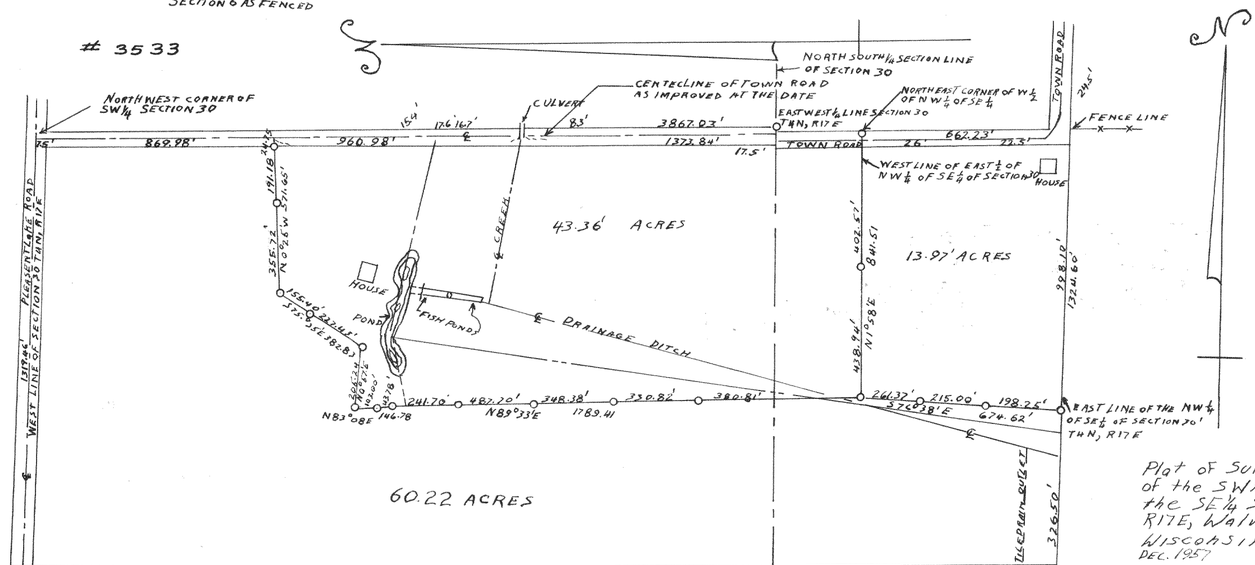
NORTH SOUTH ¼ SECTION LINE OF SECTION 30
CENTERLINE OF TOWN ROAD AS IMPROVED AT THE DATE
CULVERT
NORTH EAST CORNER OF W½ OF NW¼ OF SE¼
EAST WEST ¼ LINE SECTION 30 T4N, R17E
NORTH WEST CORNER OF SW¼ SECTION 30
TOWN ROAD
FENCE LINE
WEST LINE OF EAST ½ OF NW¼ OF SE¼ OF SECTION 30
HOUSE
43.36' ACRES
13.97' ACRES
60.22 ACRES
CREEK
DRAINAGE DITCH
POND
FISH POND
WEST LINE OF SECTION 30 T4N R17E
EAST LINE OF THE NW¼ OF SE¼ OF SECTION 30, T4N, R17E
FENCE CORNER
3879.60'
869.98'
960.98'
1372.84'
3867.03'
662.23'
N0°26'W 351.62'
S89°08E 146.78
N83°08E
N89°33E
1789.41
N1°58'E
S37°30'E
674.62'
326.50'
132.66'
398.19'
402.67'
438.96'
241.70'
487.20'
348.38'
330.82'
380.81'
266.32'
215.00'
198.26'
91.57'
94.23'
N53°W 234.57'
N53°W 3.34 CH.
137.44'
70.36'
S53°E 66.48'
N53°W 3.34 CH.
1098 C.H.
2324 6990
S37°W 267.67'
N53°W 3.34 CH.
S37°W 267.96'
198.00'
S48°21'E 125.41'
9 RODS 19½ LINKS
2587
S37°30'W 10.45 CHAINS
HIGHWAY 67 (WHITEWATER-MILWAUKEE ROAD)
1.06 CH.
