
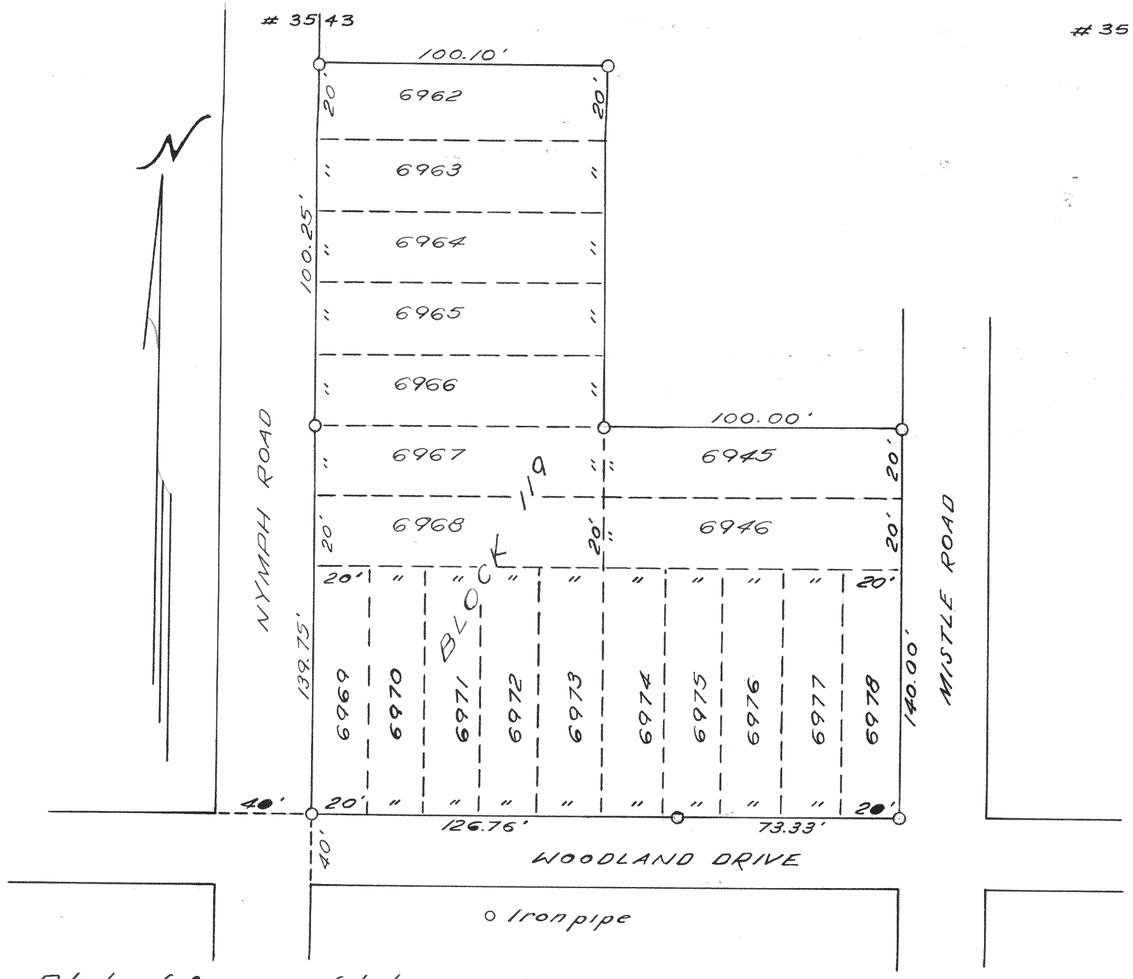


Plat of Survey of lots 6962 to 6968, 6945 to 6946 and 6969 to 6978, BLOCK 119, Lake Como Beach, located in the NW 1/4 of SECTION 28, T2N, R17E, Walworth County, Wisconsin.

July 1958


Lloyd L. Jensen
County Surveyor

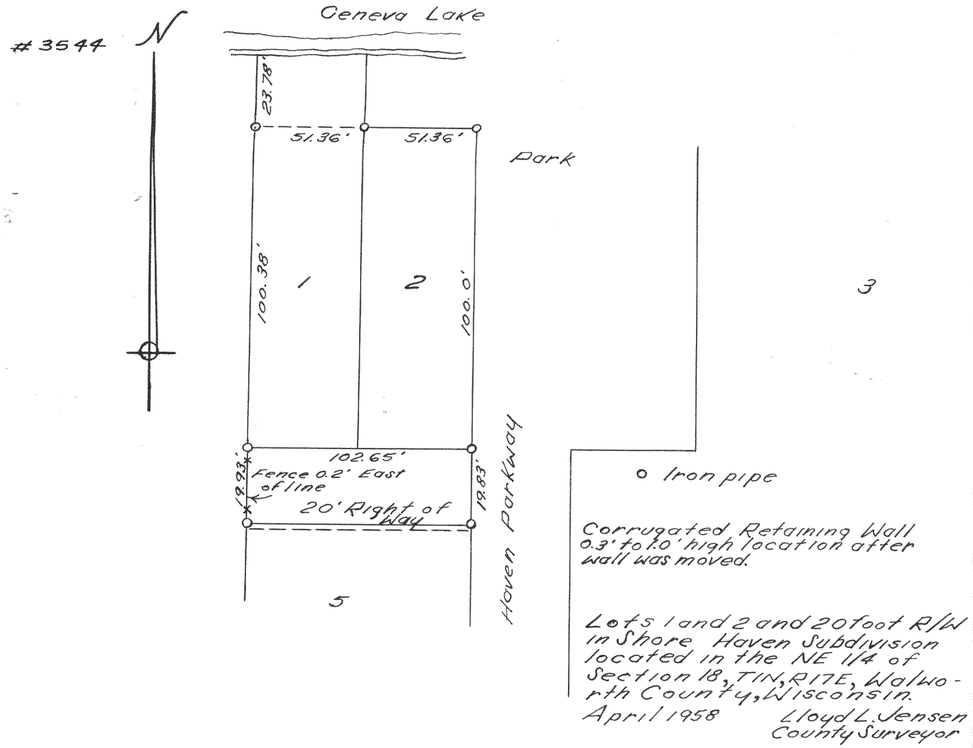

Lots 1 and 2 and 20 foot R/W in Shore Haven Subdivision located in the NE 1/4 of Section 18, T1N, R17E, Walworth County, Wisconsin.

April 1958

Lloyd L. Jensen
County Surveyor

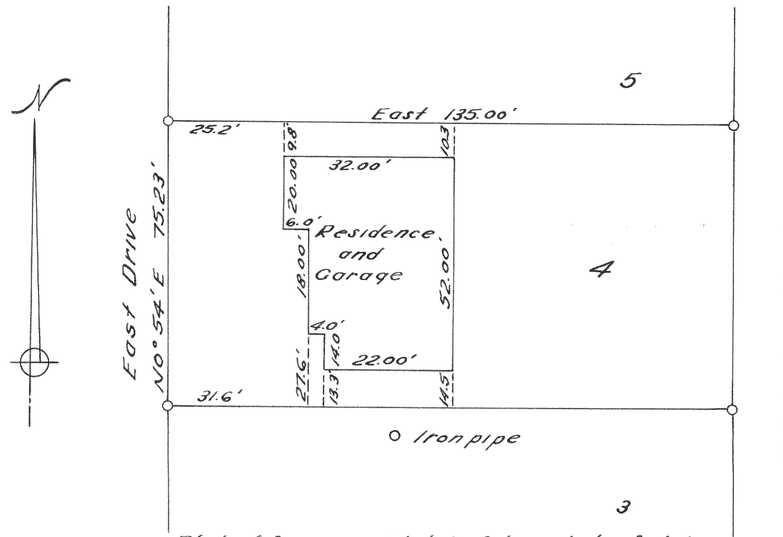

Plat of Survey of lot 4 of Lyndale Subdivision in the Village of East Troy, Walworth County, Wisconsin. Showing house location.

August 1958

Lloyd L. Jensen
County Surveyor