

3552

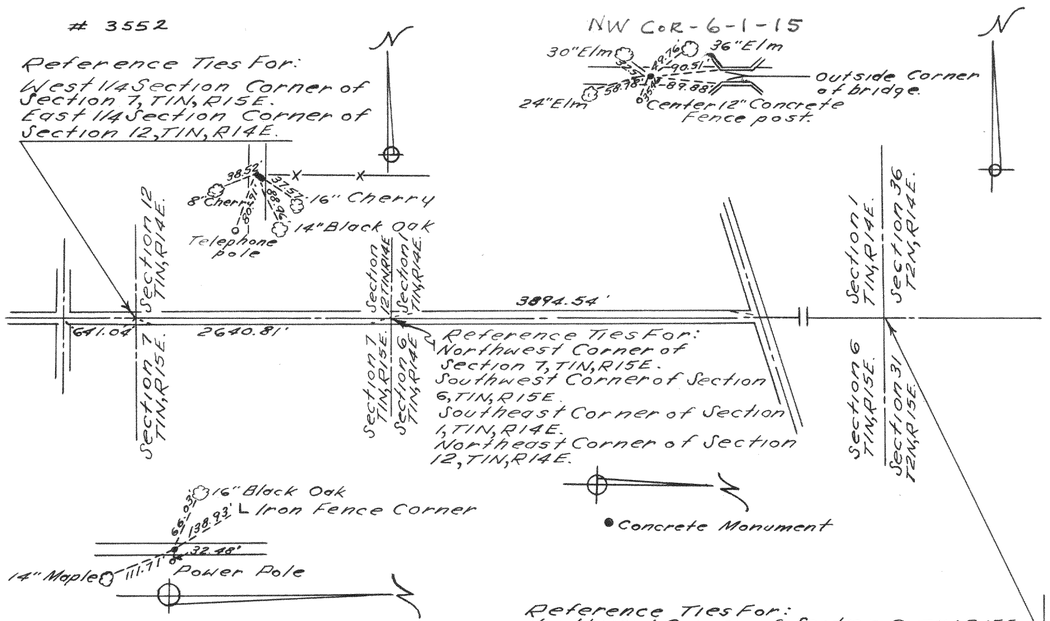


Plat of Survey of:
Sharon Town Road along West Line of Section 6 and 7, T1N, R15E, Walworth County, Wisconsin.
May 1958. Lloyd L. Jensen County Surveyor

3553

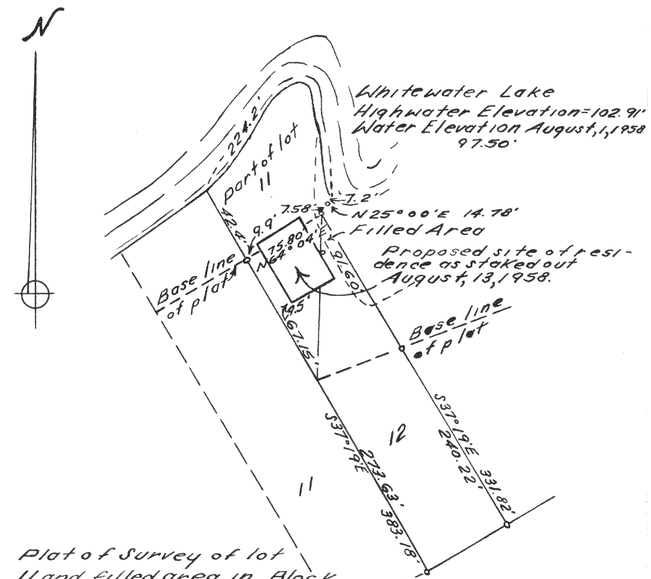


Plat of Survey of lot 11 and filled area in Block 1 of Minnieska Subdivision located in Section 35, T4N, R15E, Walworth County, Wisconsin.
August 1958. Lloyd L. Jensen County Surveyor.

3554

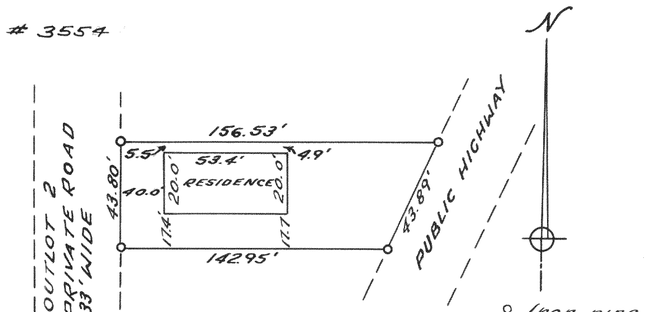

Plat of Survey of lot 12 of subdivision of lot 10, BEULAH LAKE PARK in Section 4, T4N, R18E, of Walworth County, Wisconsin
August, 1958 Lloyd L. Jensen County Surveyor

3555

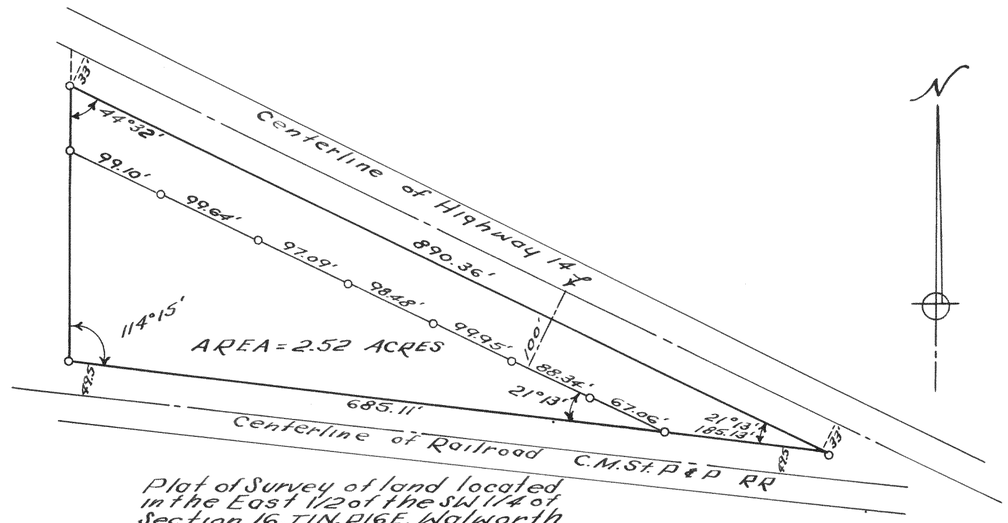

Plat of Survey of land located in the East 1/2 of the SW 1/4 of Section 16, T1N, R16E, Walworth County, Wisconsin.
August 1958 Lloyd L. Jensen County Surveyor