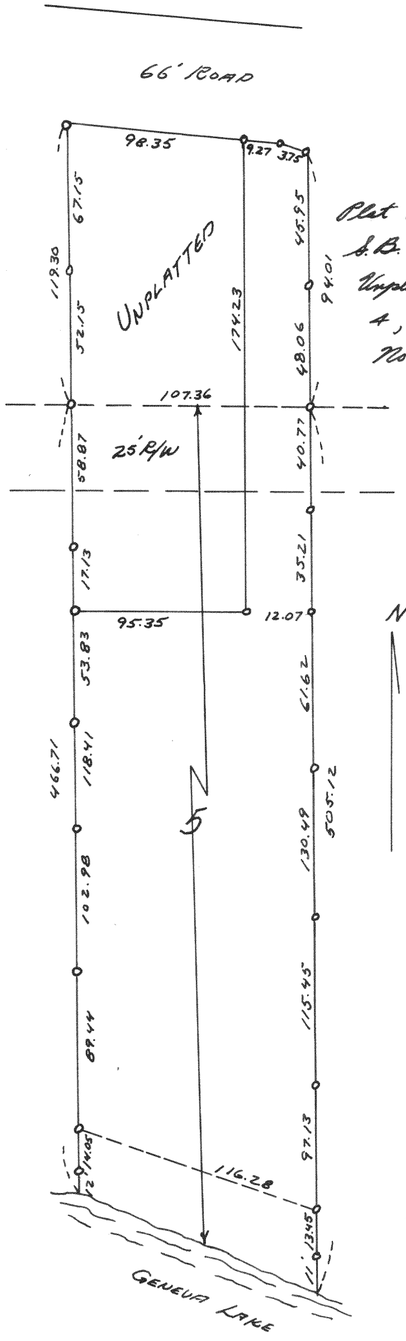
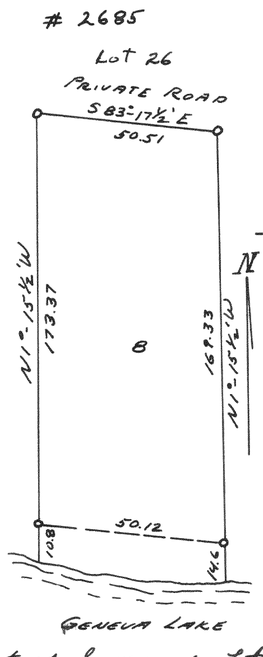
# 2684



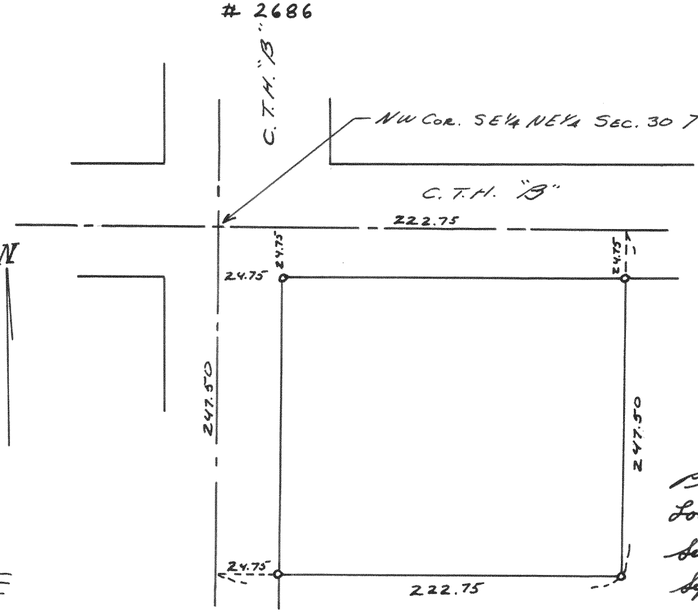

Plat of Survey of Lot 5
S. B. Chapins Subdivision and
Unplatted Land in Fr. Section
4, T1NR17E
Nov. 1953 LLJ CS

# 2685



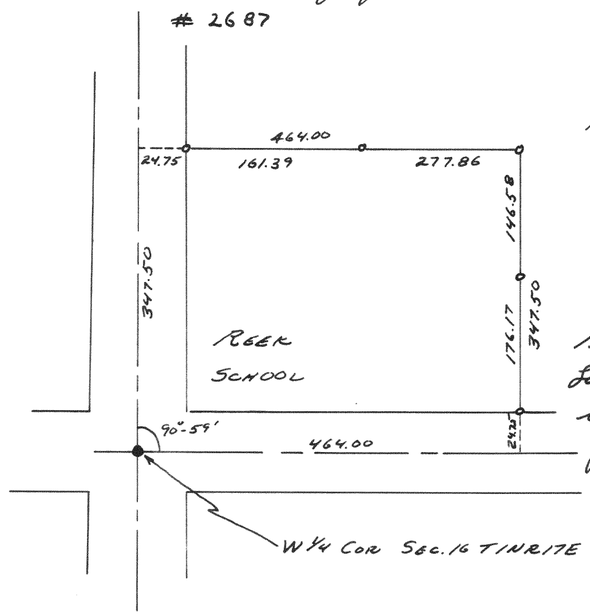

Plat of Survey of Lot 8
Elgin Club T1NR17E
July 1953 LLJ CS

# 2686



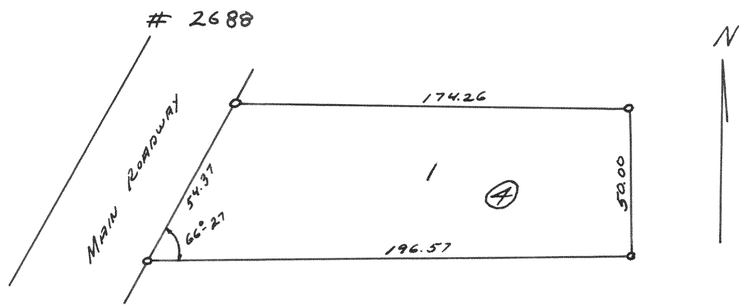

Plat of Survey of Land
Located in SE¼ NE¼
Section 30 T1NR17E
Sept. 1953 LLJ CS

# 2687




Plat of Survey of Land
Located in SW¼ NW¼
Section 16 T1NR17E
June 1953 LLJ CS

# 2688




Plat of Survey of Lot 1
Block 4 Sunset Hills Subdivision
T1NR17E
Oct. 1953 LLJ CS