

3571

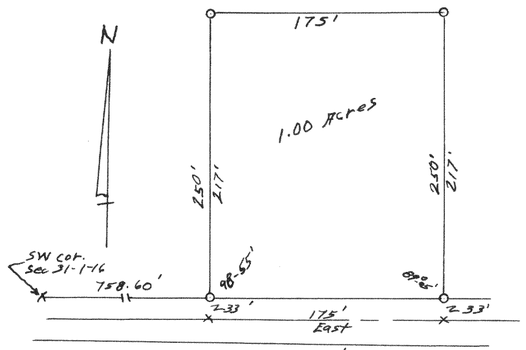

Parcel of Land in SW¼ Sec 31-1-16


3574

Lloyd L. Jensen
County Surveyor

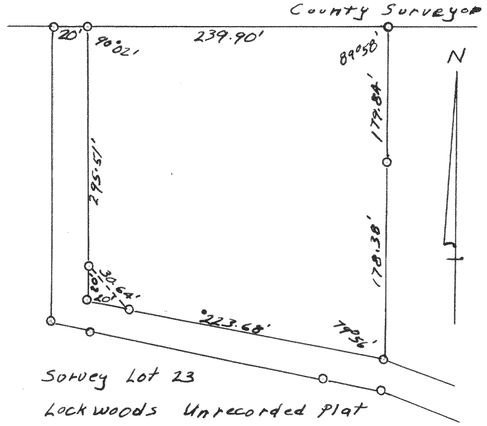

Survey Lot 23
Lockwoods Unrecorded Plat
Sec. 36-2-16 Lloyd L. Jensen
County Surveyor


3575

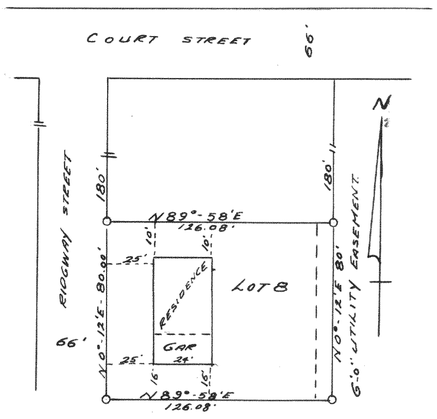

PLAT OF SURVEY OF LOT 8
OF LANDMARK SUBD. LOCATED
IN SEC. 36, T3N, R16E CITY
OF ELKHORN, WALWORTH COUNTY
WISCONSIN.


LLOYD L. JENSEN
COUNTY SURVEYOR

3572

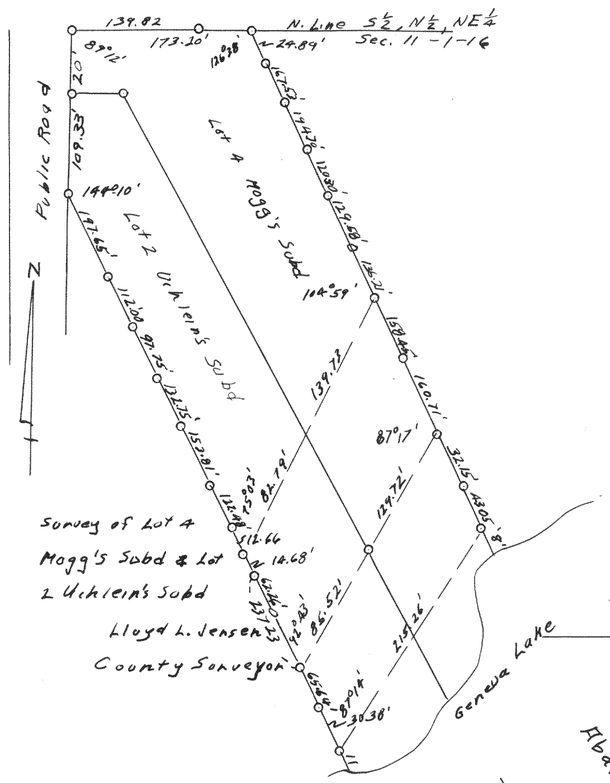


Survey of Lot 4
Mogg's Subd & Lot
2 Uchlein's Subd
Lloyd L. Jensen
County Surveyor

3573

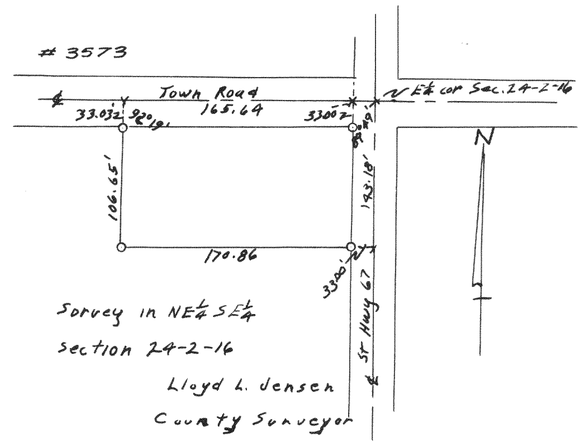

Survey in NE¼ SE¼
Section 24-2-16
Lloyd L. Jensen
County Surveyor

3576

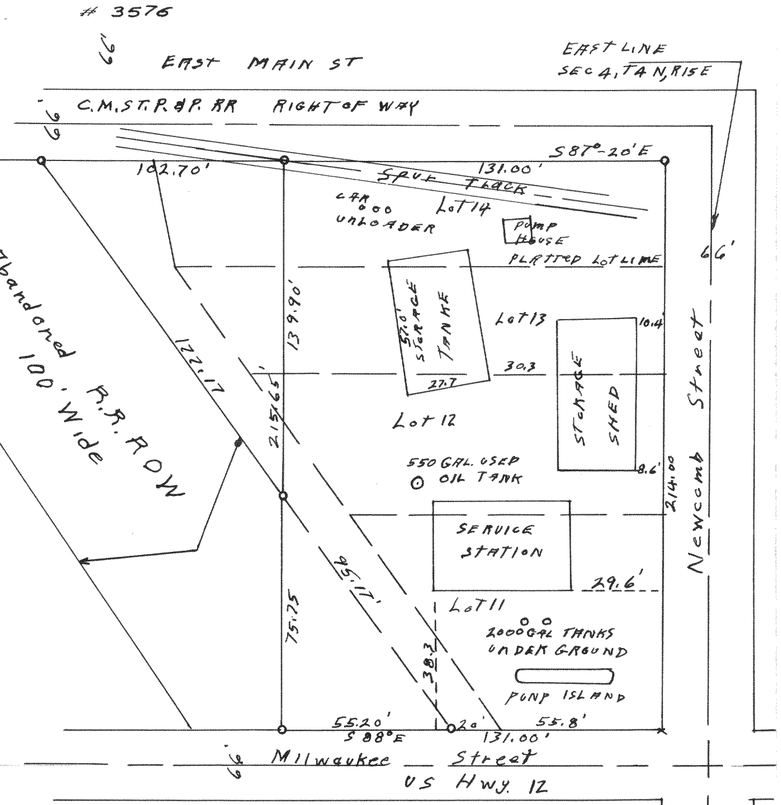

SURVEY IN THE SE 1/4
OF SEC. 4 T4N, R15E
CITY OF WHITEWATER