# 3594

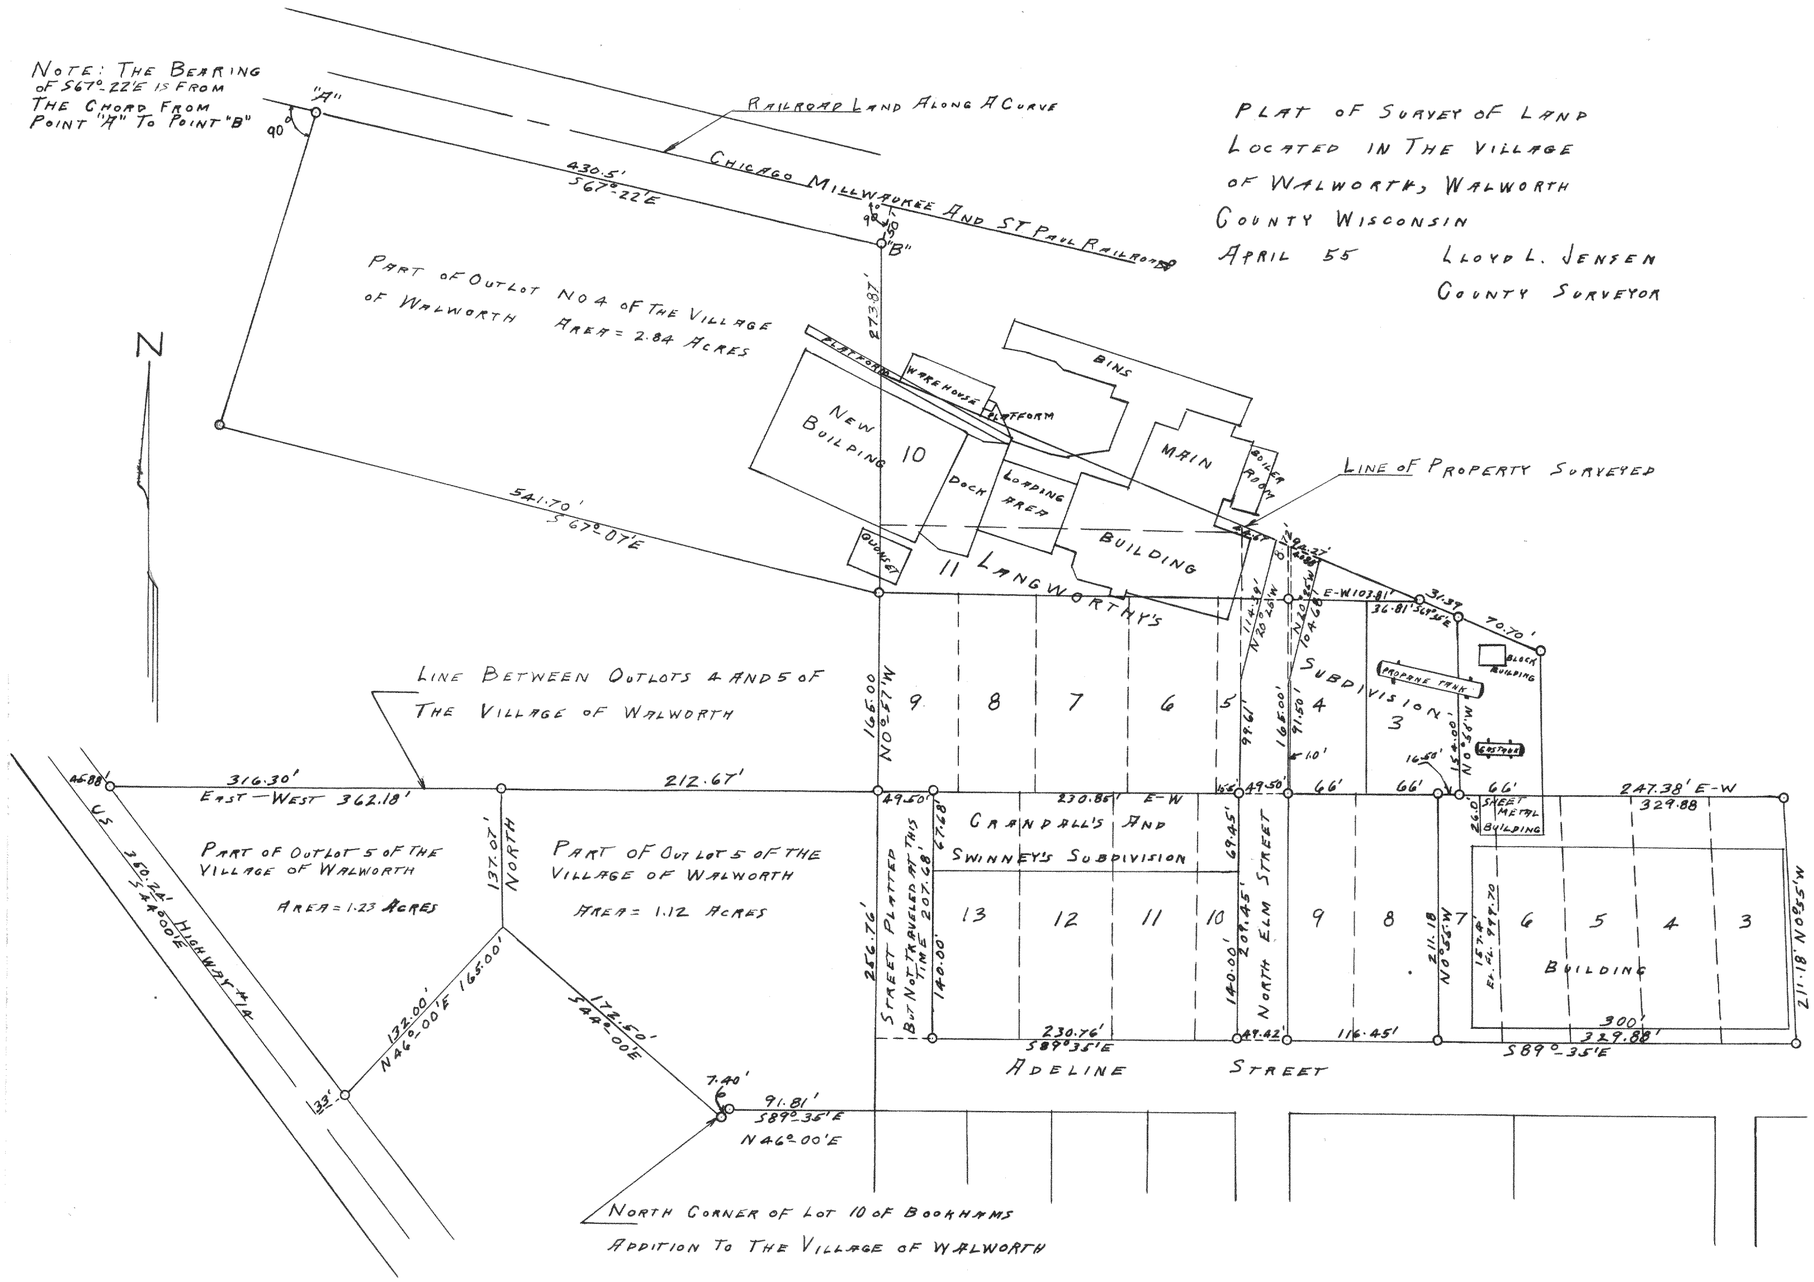


PLAT OF SURVEY OF LAND LOCATED IN THE VILLAGE OF WALWORTH, WALWORTH COUNTY WISCONSIN

APRIL 55

LLOYD L. JENSEN
COUNTY SURVEYOR