
3594

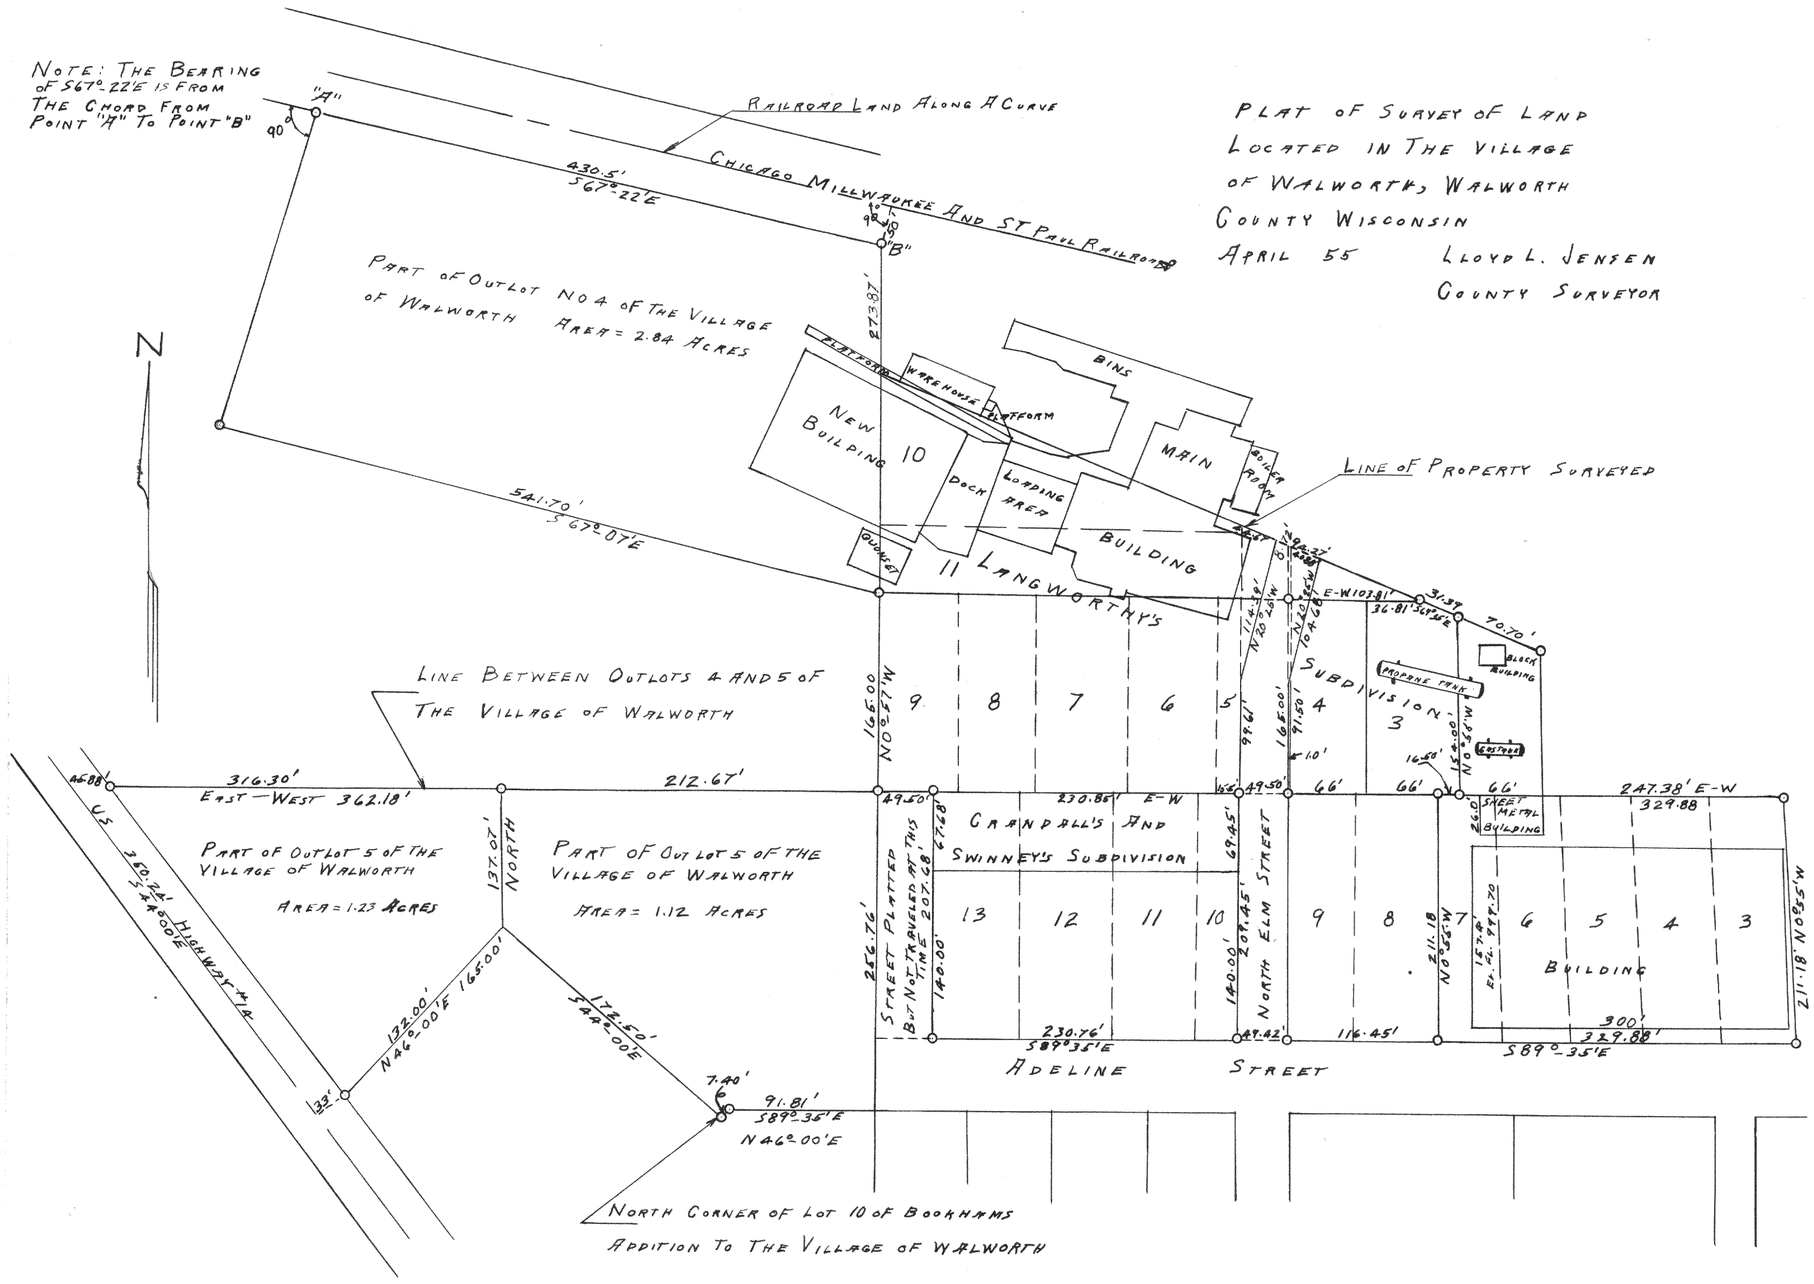

PLAT OF SURVEY OF LAND LOCATED IN THE VILLAGE OF WALWORTH, WALWORTH COUNTY WISCONSIN

APRIL 55 LLOYD L. JENSEN
COUNTY SURVEYOR