

#3595

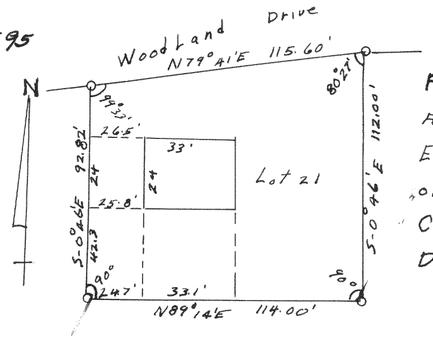


Plat of Survey of Lot 21
Add. 1"E" Country Club
Estates, Village of Fontana
on Geneva Lake, Walworth
County Wisconsin
Dec 30 58 Lloyd L. Jensen
Coonty Surveyor

#3596

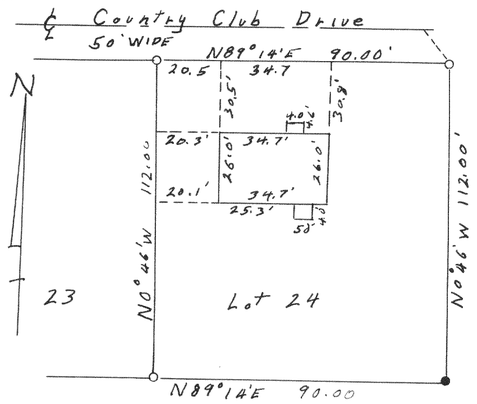


#3597

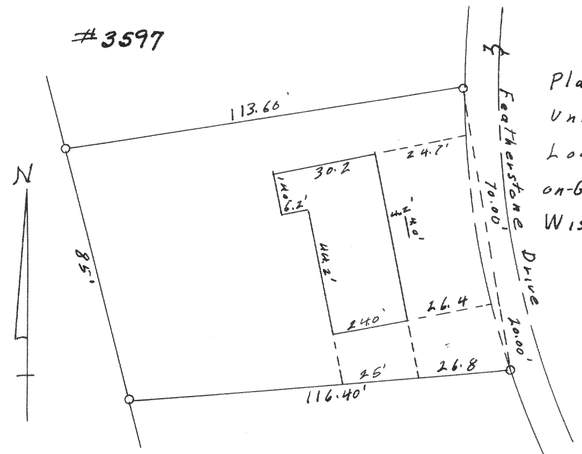

Plat of Survey of Lot 3 Block "E"
Unit 3 of Country Club Estates
Located in the Village of Fontana
on-Geneva-Lake, Walworth County
Wisconsin Lloyd L. Jensen
Dec. 58 County Surveyor


#3598

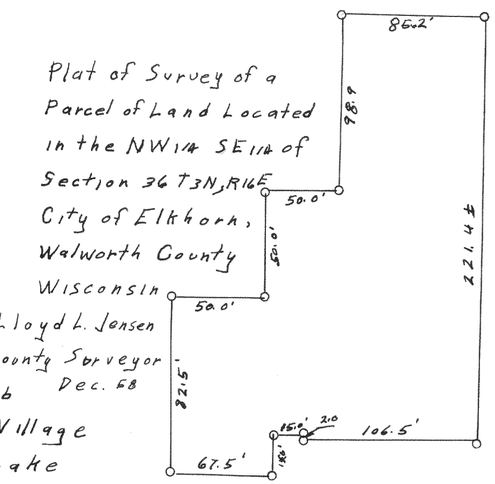

Plat of Survey of a
Parcel of Land Located
in the NW1/4 SE1/4 of
Section 36 T3N, R16E
City of Elkhorn,
Walworth County
Wisconsin
Lloyd L. Jensen
Coonty Surveyor
Dec. 58


Plat of Survey of Lot
24 Add'E" to Country Club
Estates Located in the Village
of Fontana-on Geneva Lake
Walworth County Wisconsin
Dec. 1958 Lloyd L. Jensen
County Surveyor

#3599

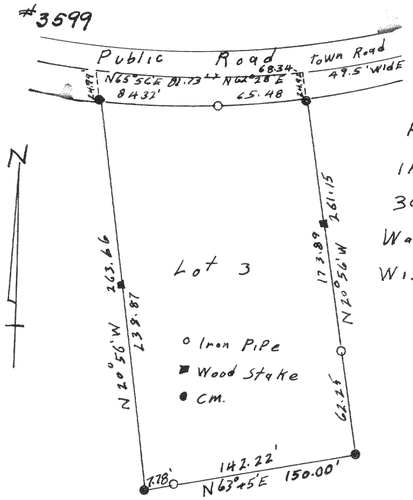


Plat of Survey of A
Parcel of Land Located
in the West 1/2 of Sec.
30, T2N, R18E,
Walworth County
Wisconsin Nov. 58
Lloyd L. Jensen
County Surveyor

#3600

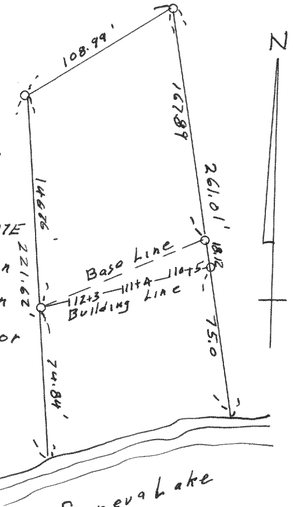

Plat of Survey of Lot 3
Forest Rest Subd.
Located in Sec. 2 T1N, R17E
Walworth County Wisconsin
Nov. 58 Lloyd L. Jensen
County Surveyor

#3601

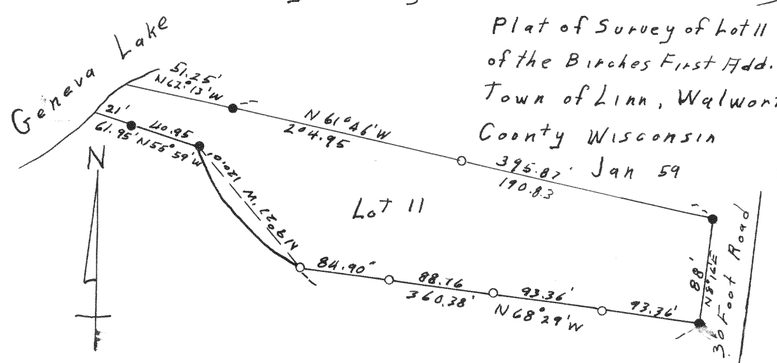

Plat of Survey of Lot 11
of the Birches First Add.
Town of Linn, Walworth
County Wisconsin Lloyd L. Jensen
Jan 59 County Surveyor