

2689

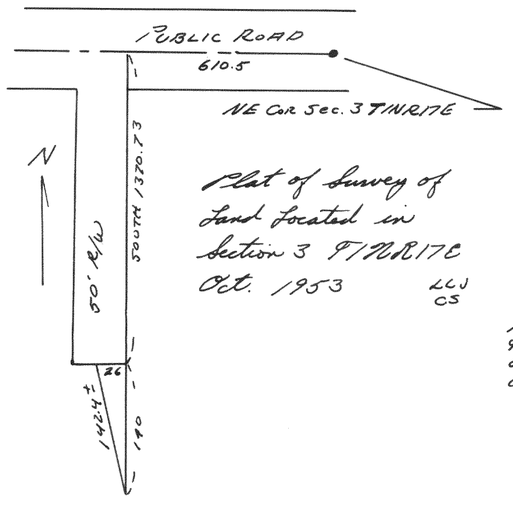


Plat of Survey of
Land Located in
Section 3 T1NR17E
Oct. 1953 LLJ CS

2690

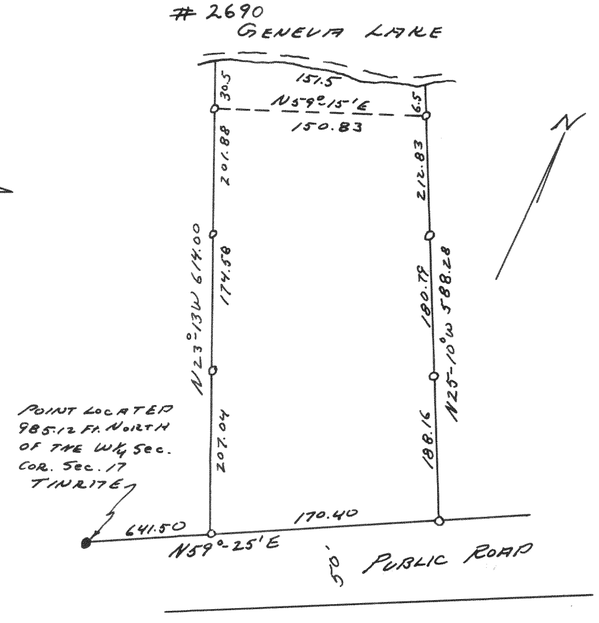


2691

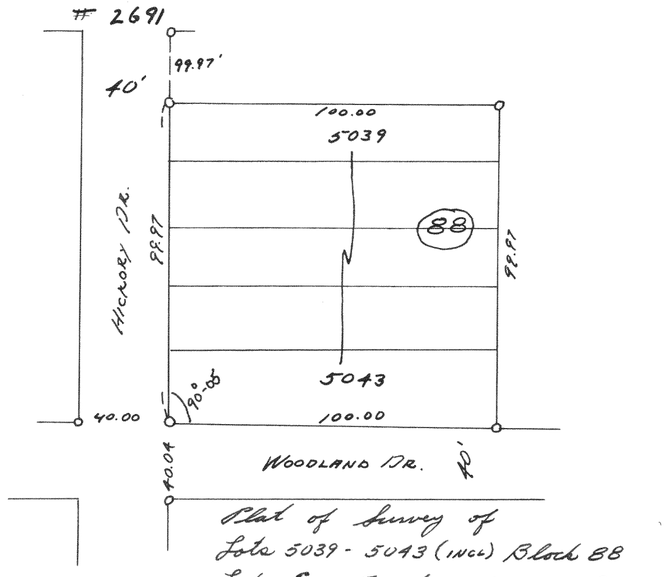


Plat of Survey of
Lots 5039 - 5043 (incl) Block 88
Lake Como Beach T2NR17E
Oct 24, 1953 LLJ CS


2692

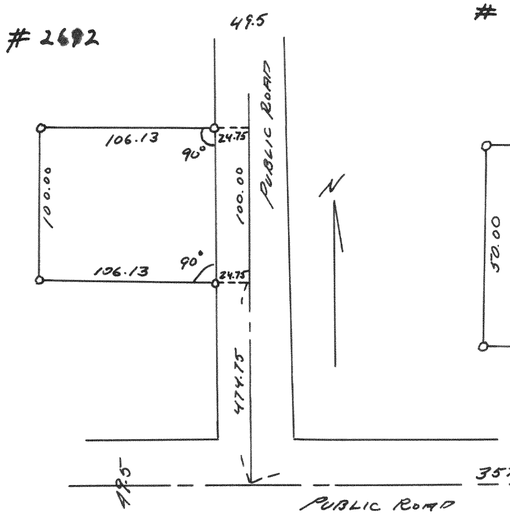

2693


Plat of Survey of Lot 85
Lake Geneva Beach T1NR17E
Nov. 1953 LLJ CS

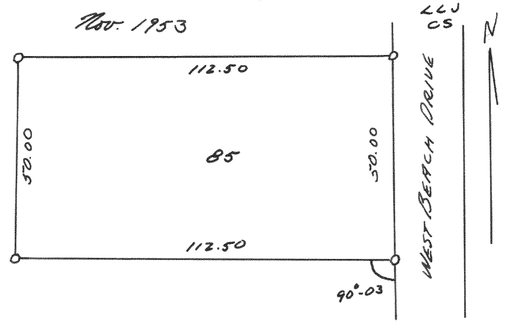

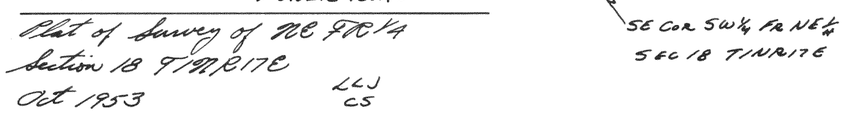

Plat of Survey of NE Fr¼
Section 18 T1N R17E
Oct 1953 LLJ CS

2694

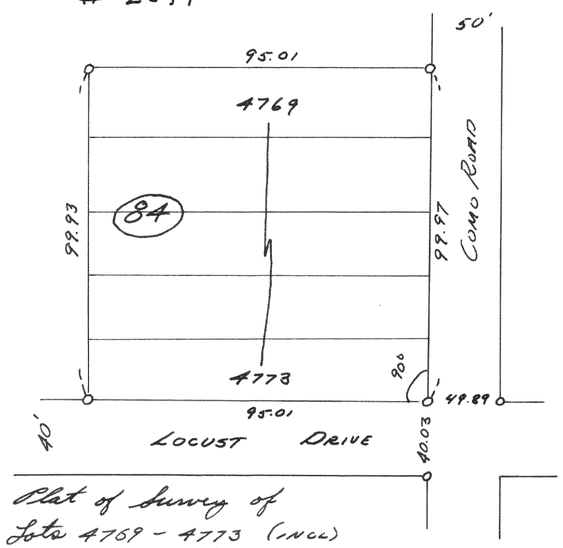

Plat of Survey of
Lots 4769 - 4773 (incl)
Block 84 Lake Como Beach
T2NR17E LLJ CS
Sept 1953