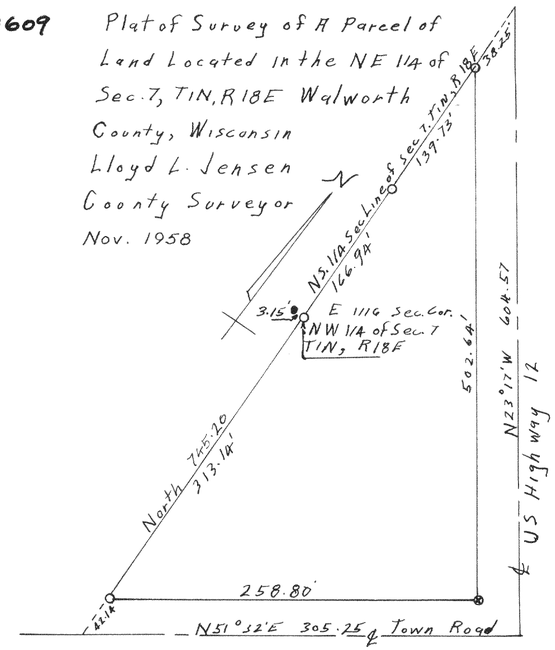
#3609

Plat of Survey of A Parcel of Land Located in the NE 1/4 of Sec. 7, T1N, R18E Walworth County, Wisconsin


Lloyd L. Jensen
County Surveyor
Nov. 1958





#3610

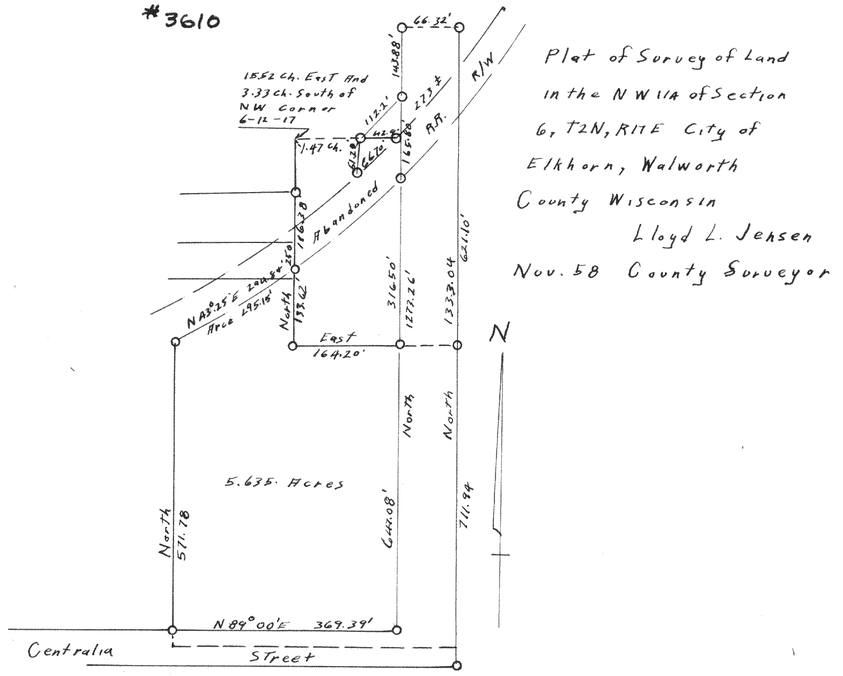Plat of Survey of Land in the NW 1/4 of Section 6, T2N, R17E City of Elkhorn, Walworth County Wisconsin

Lloyd L. Jensen
Nov. 58 County Surveyor





#3611

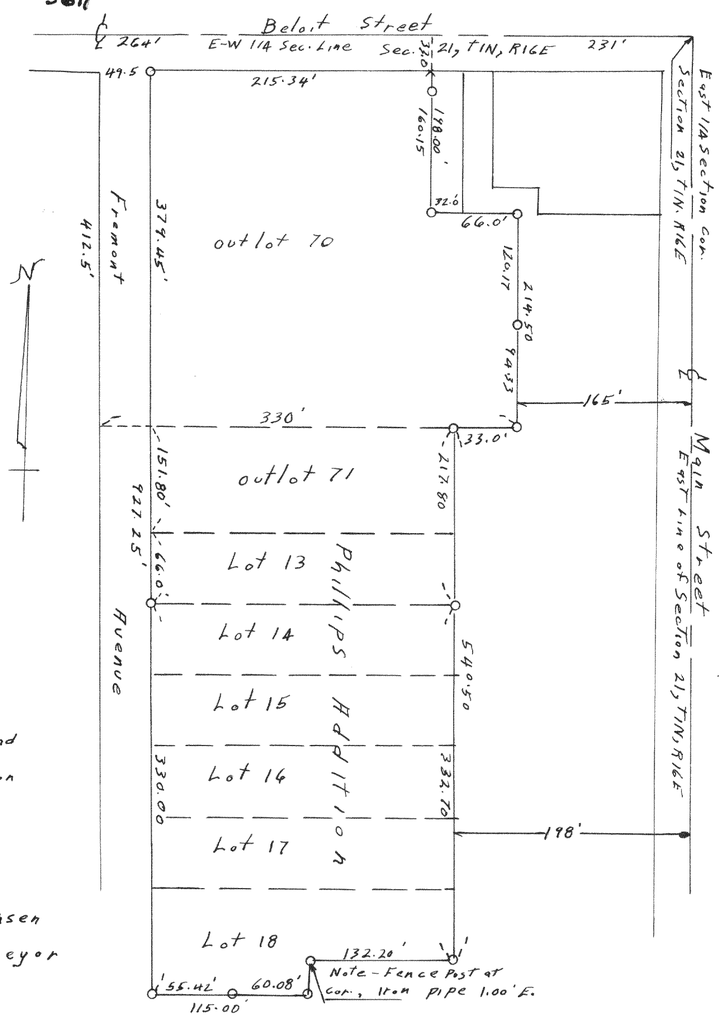


Plat of Survey of outlots 70 and 71 and Lots 13 to 18 Phillips Addition Village of Walworth, Walworth County, Wisconsin

Lloyd L. Jensen
Jan 59 County Surveyor

#3612

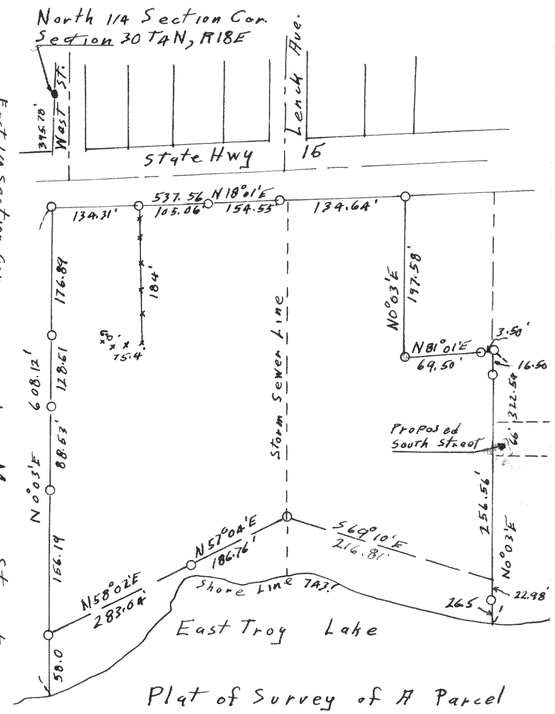


Plat of Survey of A Parcel of Land Located in the NW 1/4 of the NE 1/4 of Section 30 T4N-R18E Village of East Troy Walworth County Wisconsin

June 58 Lloyd L. Jensen
County Surveyor