

#3629

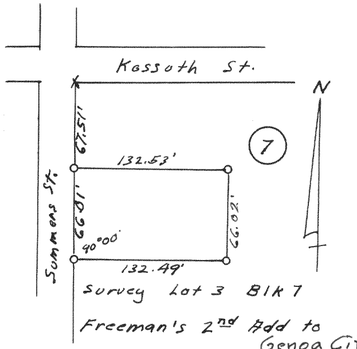


Survey Lot 3 Blk 7
Freeman's 2nd Add to
Genoa City,
the Village of ~~Warworth~~

#3630 (8-22-58) Lloyd L Jensen County Surveyor

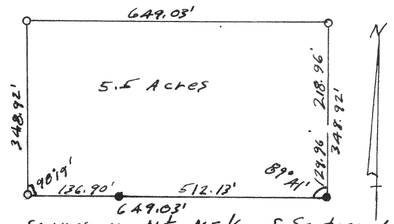


Survey in N½ NE¼ of Section 1
City of Lake Geneva Lloyd L. Jensen
July 1957 County Surveyor

#3631

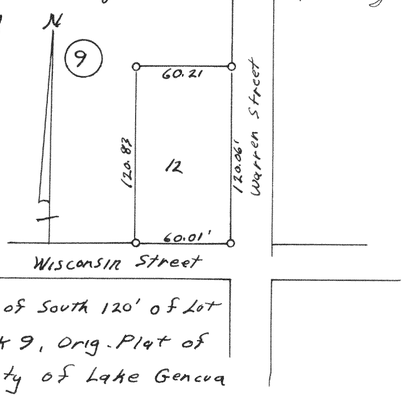


Survey of South 120' of Lot
12, Blk 9, Orig. Plat of
the City of Lake Geneva
June 1958 Lloyd L Jensen
County Surveyor

#3632

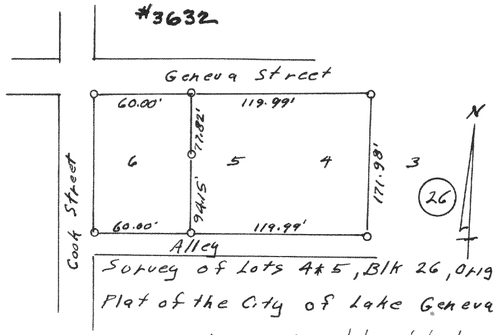


Survey of Lots 4 & 5, Blk 26, Orig.
Plat of the City of Lake Geneva
Aug. 1958 Lloyd L. Jensen
County Surveyor

#3633

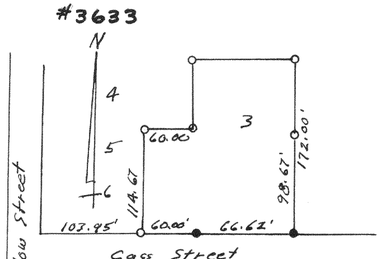


Survey of Lot 3 and the East
60' of Lots 5 and 6 Newberry's
Subd. City of Lake Geneva
Oct 20, 1958 Lloyd L. Jensen
County Surveyor

#3634

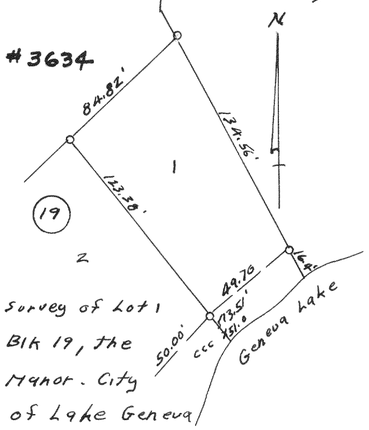


Survey of Lot 1
Blk 19, the
Manor. City
of Lake Geneva
Oct 1958 Lloyd L. Jensen
County Surveyor

#3635

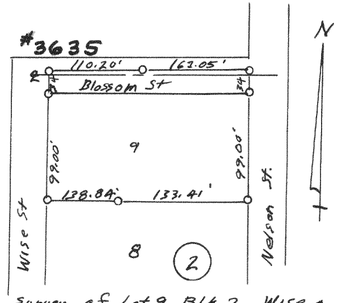


Survey of Lot 9, Blk 2, Wise &
Nelsons Add to the Village
of Sharon Lloyd L. Jensen
May 1957 County Surveyor

#3636

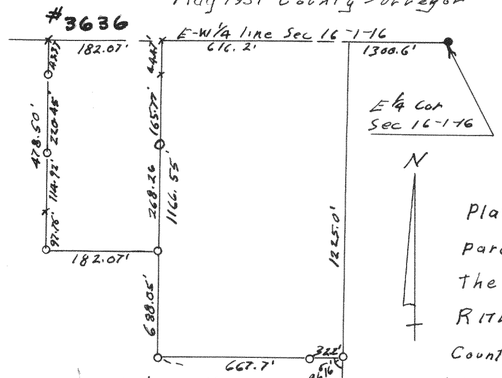


Survey in W½ SE¼ Section
16, T1N, R16E Lloyd L. Jensen
1958 County Surveyor

#3637

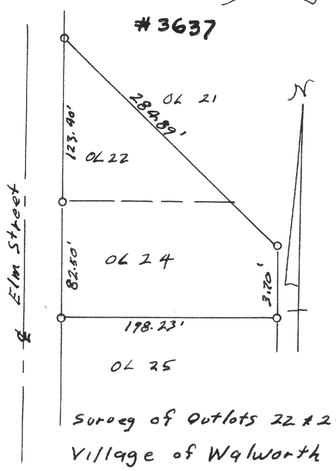

Survey of Outlots 22 & 24
Village of Walworth
Sept 1958 Lloyd L. Jensen
County Surveyor

#3638

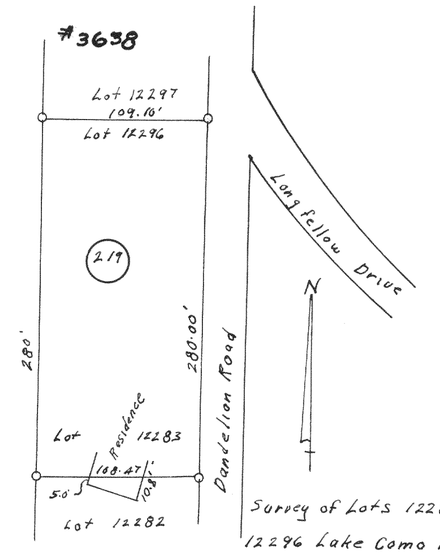

Survey of Lots 12283 -
12296 Lake Como Beach
T2N, R17E, Walworth County, Wisconsin
Oct 1958 Lloyd L Jensen
County Surveyor

#3639

