

226 # 3645

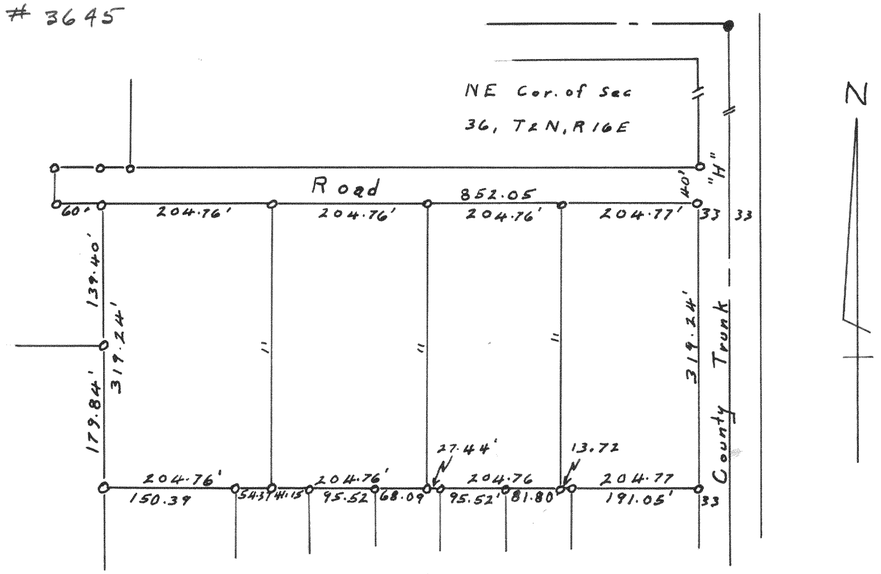

Survey of a parcel of land located in the E ½ of the NE ¼ of Section 36, T2N R16E Walworth County Wisconsin Sept. 1961

Floyd L Jensen
County Surveyor


3646

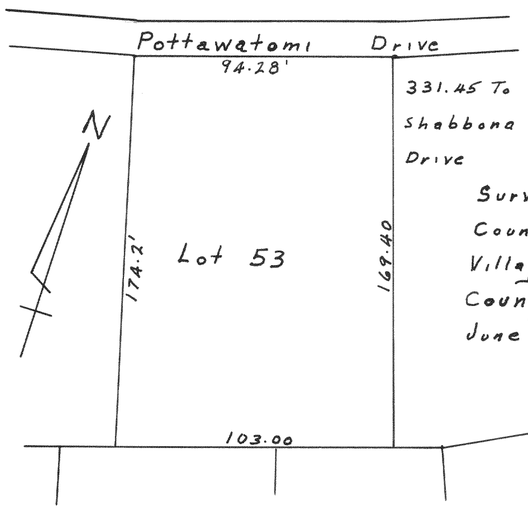

Survey of lot 53 Unit 2, Country Club Estates, Village of Fontana, Walworth County Wisconsin June 1961

Floyd L Jensen
County Surveyor

3647

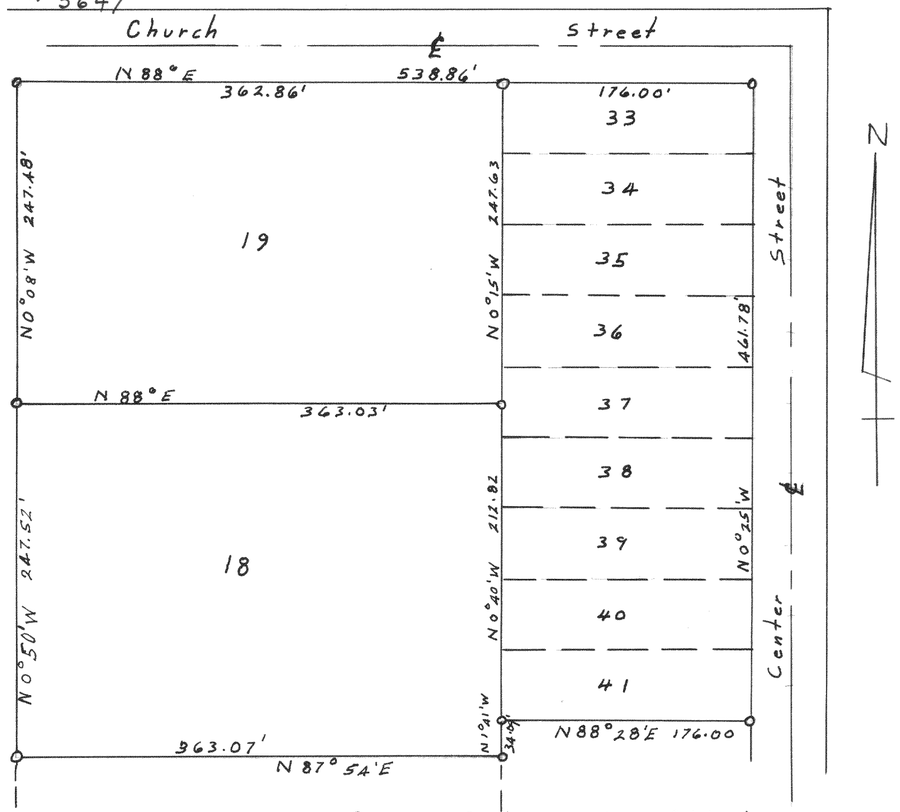

Survey of lots 18 and 19 of block 7 of Citizens Add. and lots 33 to 41 of the Shanahan Subd of lot 20 of block 7 of Citizens Add. Located in the Village of Sharon, Walworth County Wisconsin July, 1961

Floyd L Jensen
County Surveyor

