
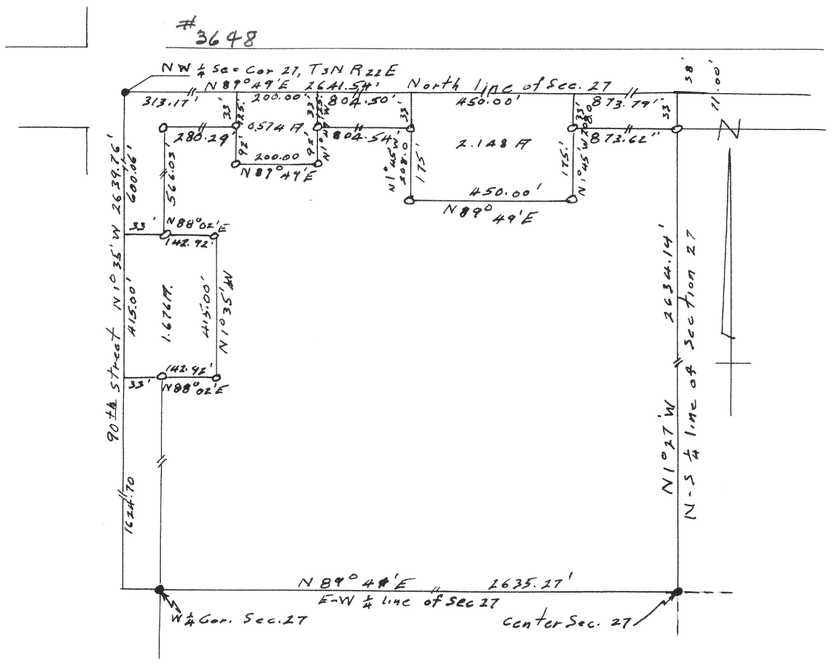



Plat of survey of the NW ¼ of section 27, T3N. R22E, Racine County, Wisconsin
May 1961

Floyd L Jensen
County Surveyor

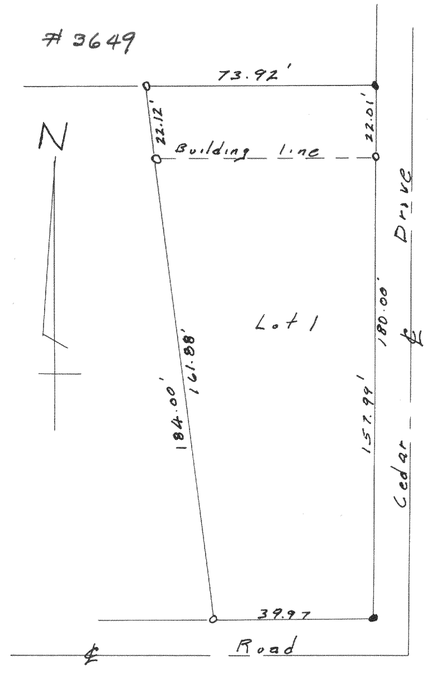


Survey of lot 1 Cedar Point Park First Addition. Village of Williams Bay, Walworth County Wisconsin
oct 1961

Floyd L. Jensen
County Surveyor

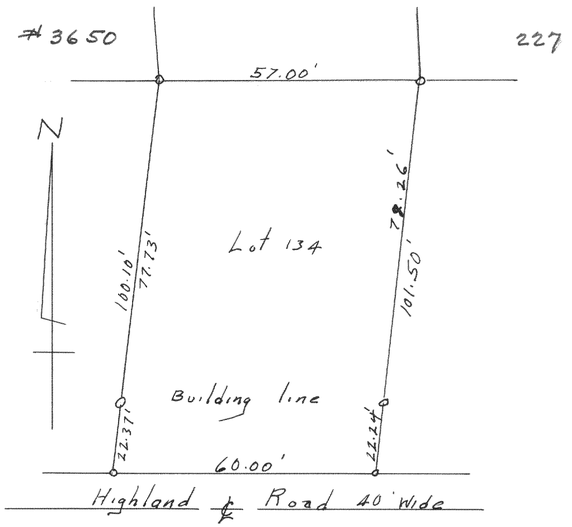


Survey of lot 134, Cider Point Park Second Addition, Williams Bay Walworth County, Wisconsin
Nov. 1961

Floyd L Jensen
County Surveyor

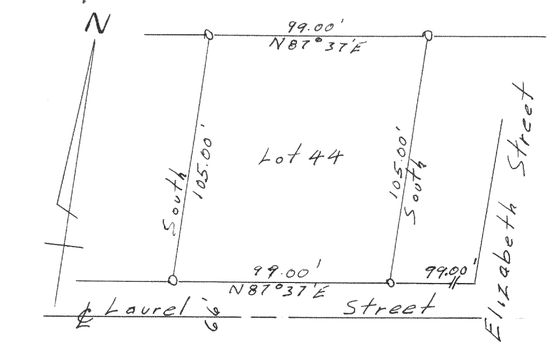

Survey of lot 44 - Westport Add.
City of Whitewater, Walworth County Wisconsin
Nov. 1961

Floyd L Jensen
County Surveyor

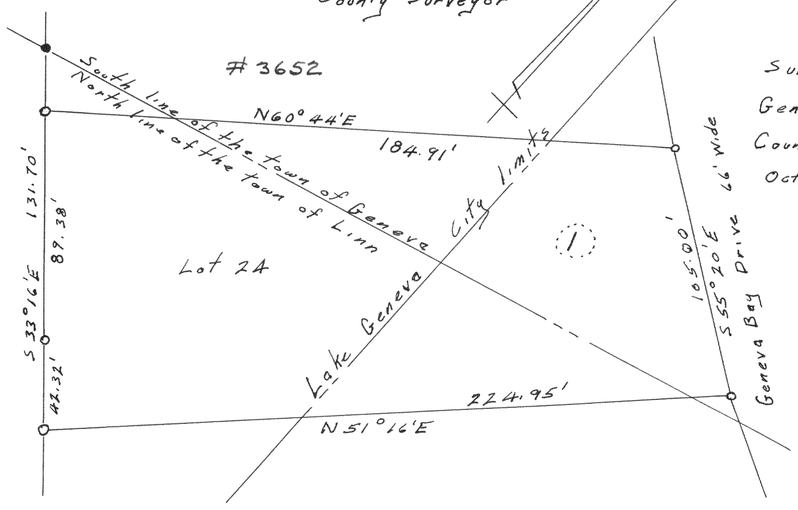

Survey of lot 24, Block one Geneva Bay Estates Walworth County Wisconsin
Oct 1961

Floyd L Jensen
County Surveyor