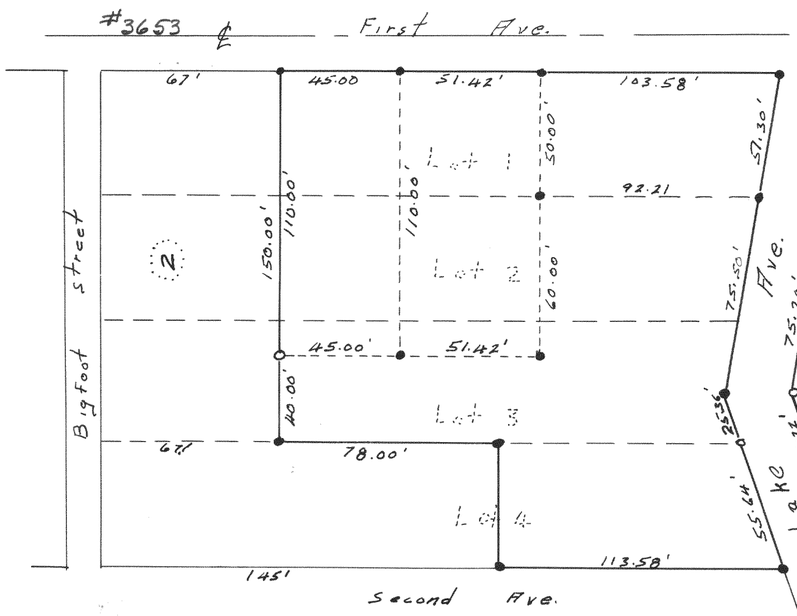

Plat of survey of a parcel of land located in block 1 and 2 of D.A. Reids Add. to Reids Park, Village of Fontana-on-Geneva Lake Walworth County Wisconsin
Oct 1961

Floyd L Jensen
County Surveyor

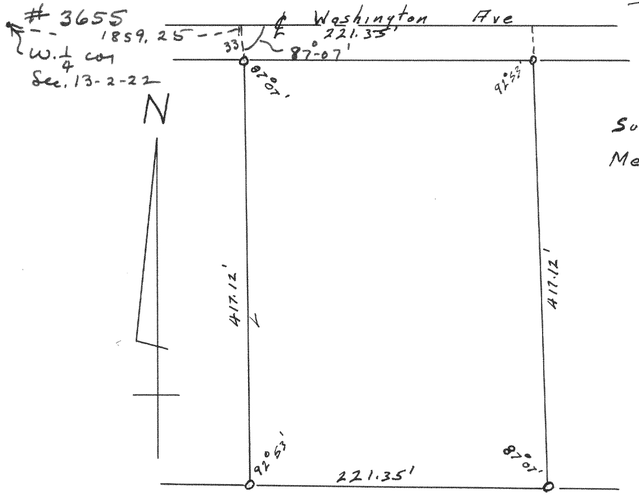

Survey of the Racine Medical Clinic

Floyd L Jensen
County Surveyor

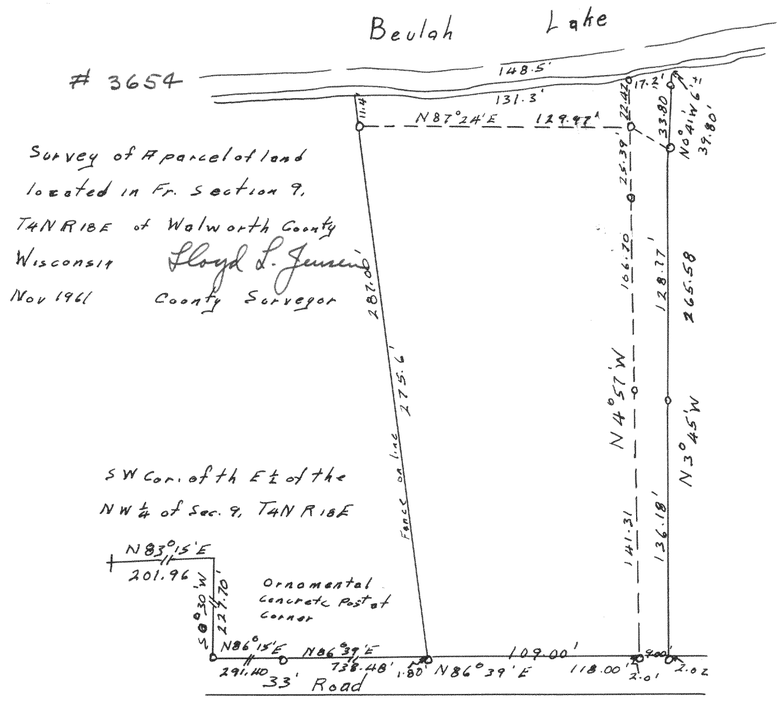

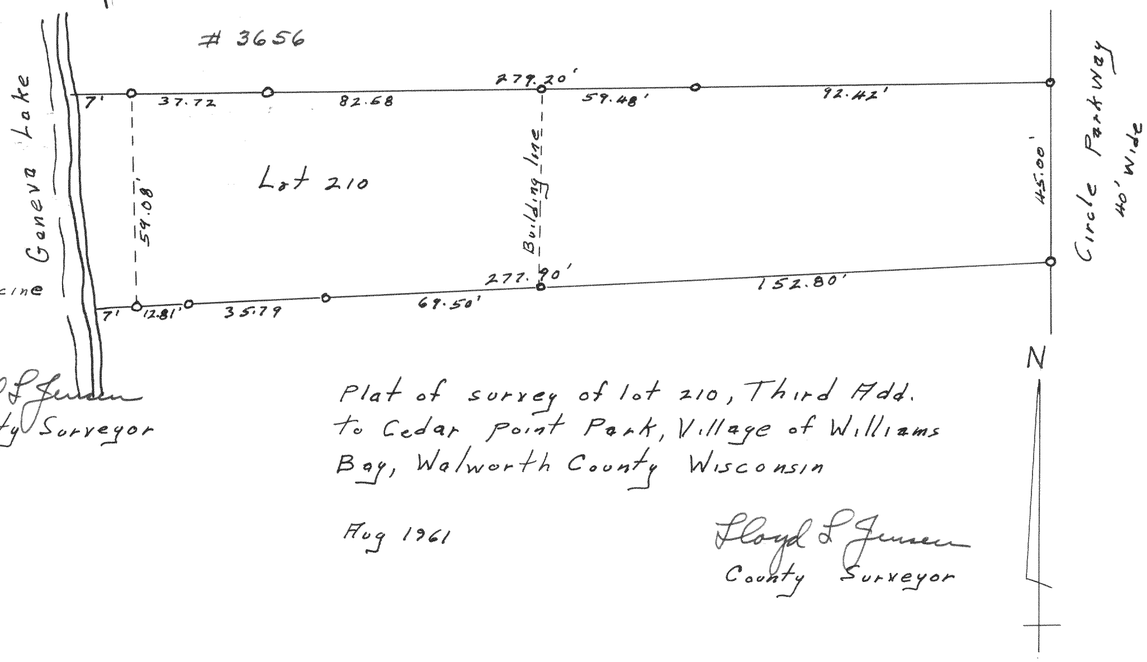

Plat of survey of lot 210, Third Add. to Cedar Point Park, Village of Williams Bay, Walworth County Wisconsin

Aug 1961

Floyd L Jensen
County Surveyor