

#3657

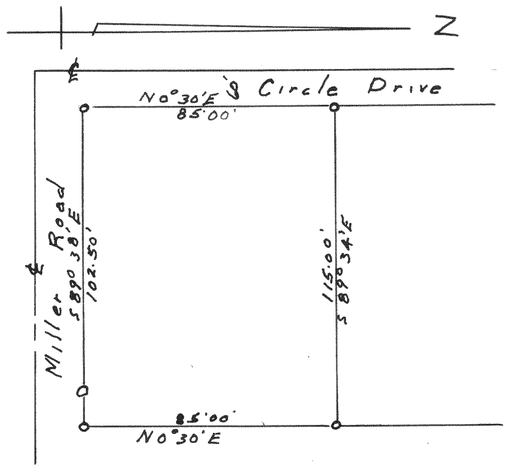

Survey of lot 122 of Sturwood Add No. 6 IN T2N. R17E Walworth County Wisconsin
Aug. 1961

Floyd L Jensen
County Surveyor


#3660

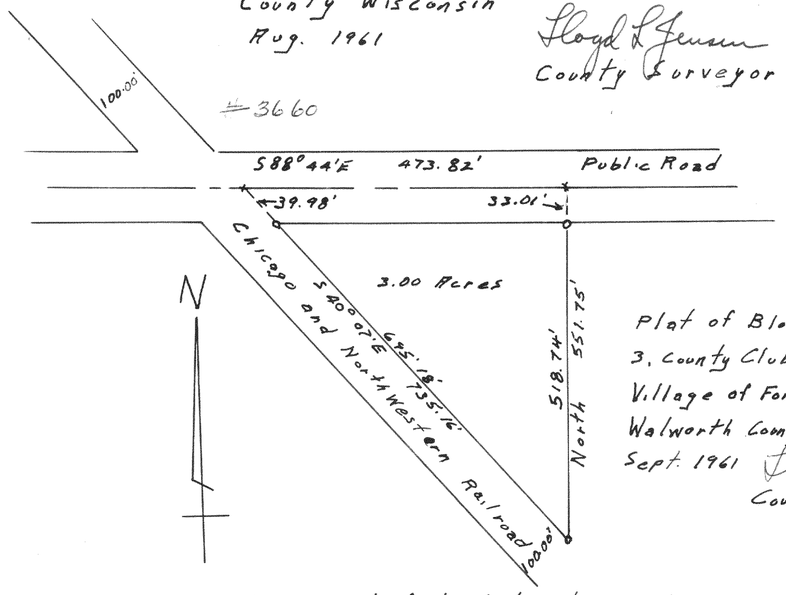

A parcel of land located in the NE ¼ of the S W ¼ of Sec. 16 T1N R18E Walworth County Wisconsin
Oct. 1961

Floyd L Jensen
County Surveyor

#3658

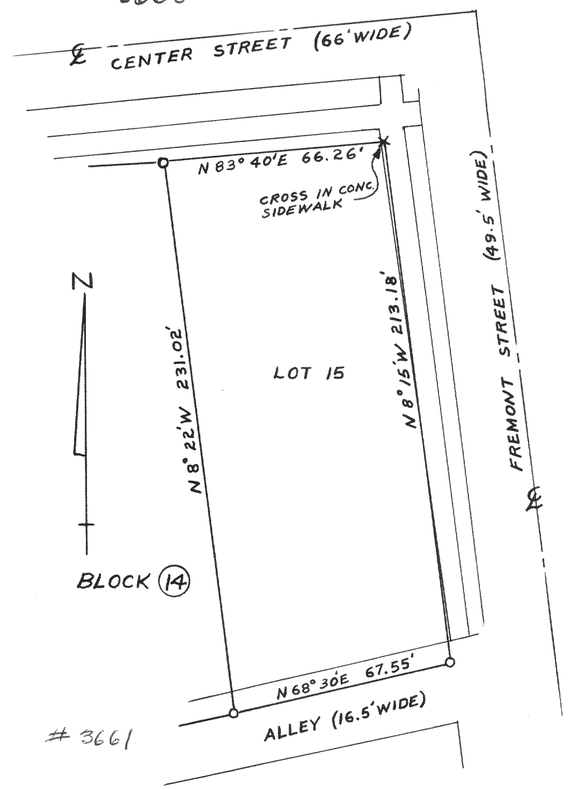


#3661

SURVEY OF LOT 15, BLOCK 14, CITY OF WHITEWATER, WALWORTH COUNTY,
MAY, 1961


Floyd L Jensen
COUNTY SURVEYOR

Plat of Block C, Unit 3, County Club Estates, Village of Fontana 17
Walworth County Wisconsin
Sept. 1961

Floyd L Jensen
County Surveyor

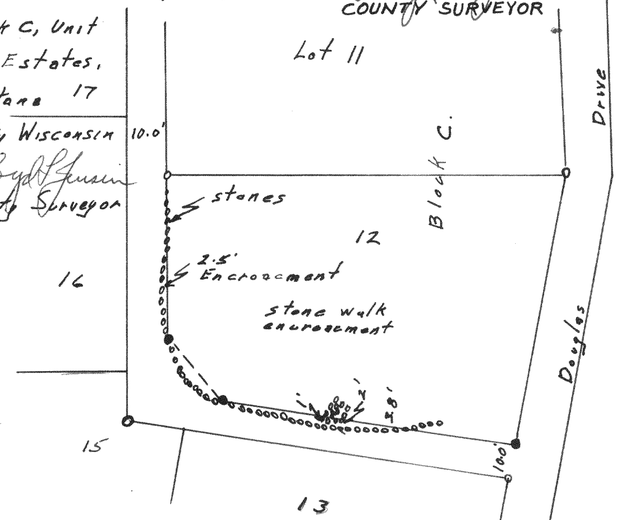


#3659

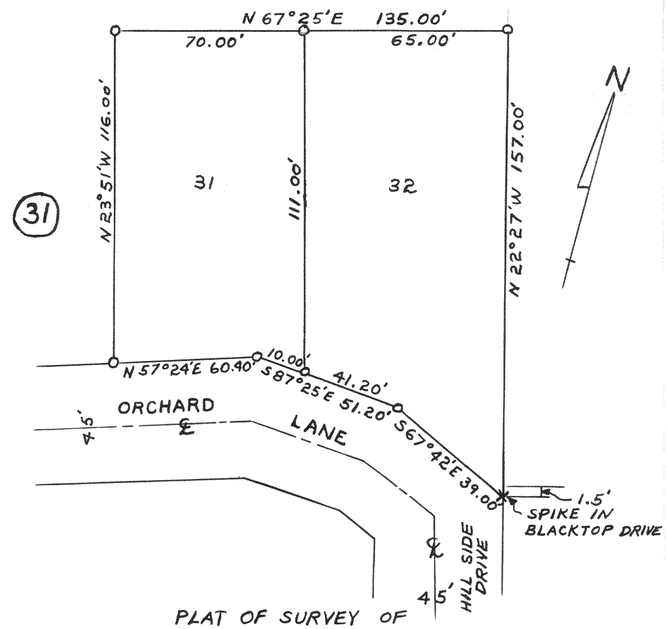

PLAT OF SURVEY OF
LOTS 31 & 32, BLOCK 31, LAKE GENEVA MANOR,
LAKE GENEVA, WALWORTH COUNTY, WISCONSIN
MAY, 1961

Floyd L Jensen
COUNTY SURVEYOR

#3662

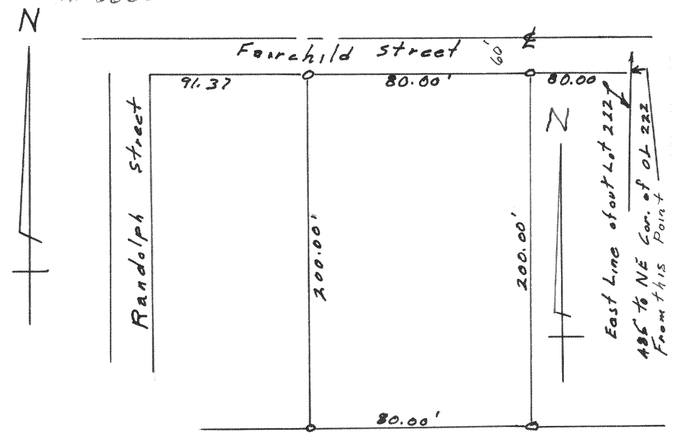

A parcel of land located in outlot 222 of the Assessor's plat of the Village of Walworth, Walworth County Wisconsin
Aug 1961

Floyd L Jensen
County Surveyor