

#3663

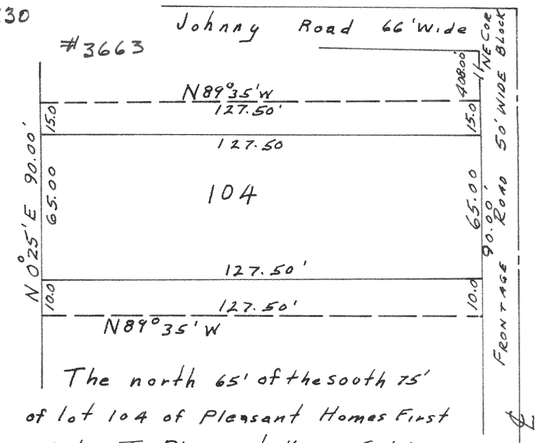

The north 65' of the sooth 75' of lot 104 of Pleasant Homes First Addition To Pleasant Homes Subd. in Sec 35 T1N R22E Kenosha County Wisconsin July 1961

Lloyd L Jensen
County Surveyor


#3664

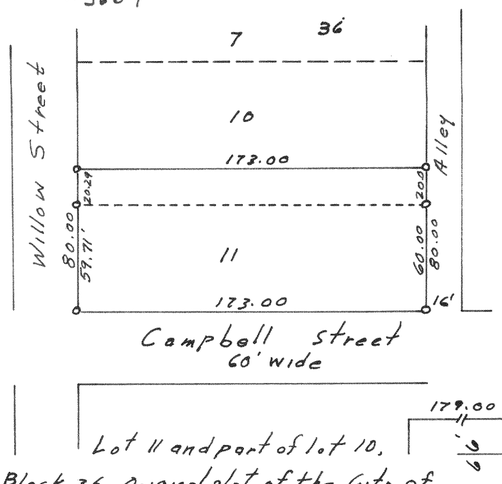

Lot 11 and part of lot 10, Block 36, original plat of the City of Lake Geneva, Walworth County Wisconsin May 1961

Lloyd L Jensen
County Surveyor


#3665

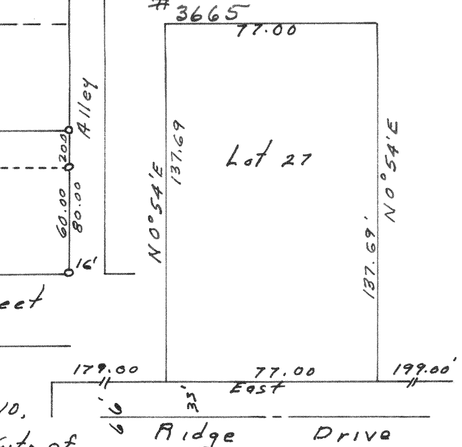

Lot 27, Lyndale Subd. Village of East Troy Walworth County Wisconsin Nov. 1961

Lloyd L Jensen
County Surveyor

#3666

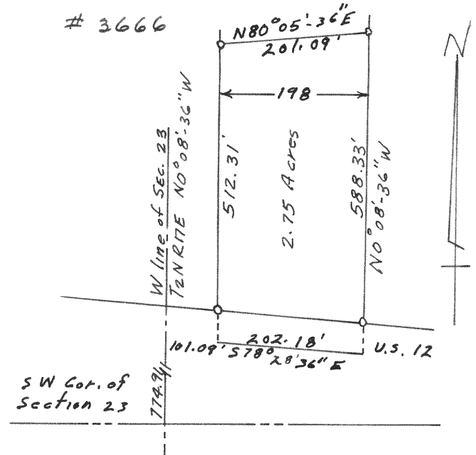

A parcel of land located in the west ½ of SW ¼ of Section 23, T2N R17E Walworth County Wisconsin Aug. 1961


Lloyd L Jensen
County Surveyor

#3667

Lot 17 Block 5 Perkins Park Add To City of Burlington, Racine County Wisconsin Nov. 1961

Lloyd L Jensen
County Surveyor


#3668

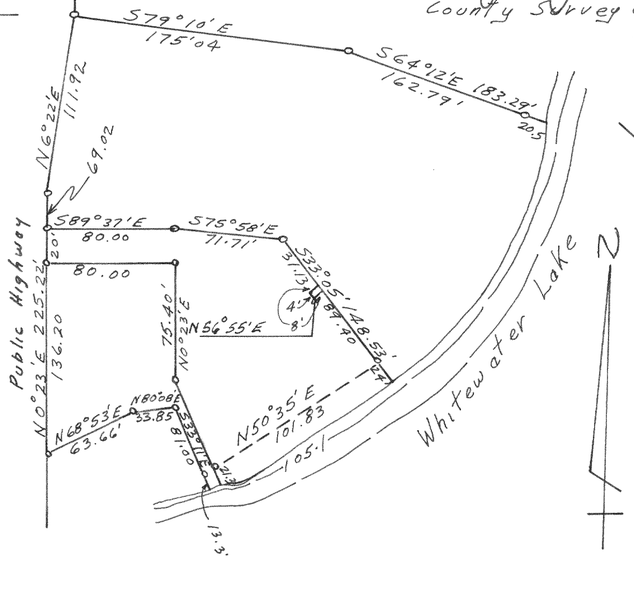

A parcel of land located in the NE ¼ of the SE ¼ of Sec. 34, T4N, R15E Walworth County Wisconsin Aug 1961

Lloyd L Jensen
County Surveyor

#3669

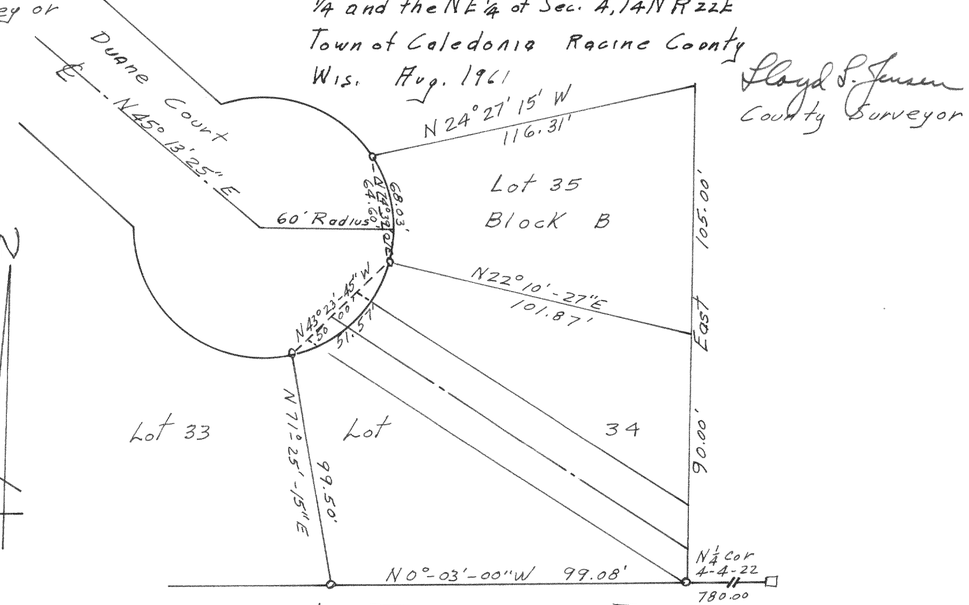

Lots 34 and 35 of block B, Caddy Vista South, First Add in the NW ¼ and the NE ¼ of Sec. 4, T4N R22E Town of Caledonia Racine County Wis. Aug. 1961

Lloyd L Jensen
County Surveyor

