




#3670

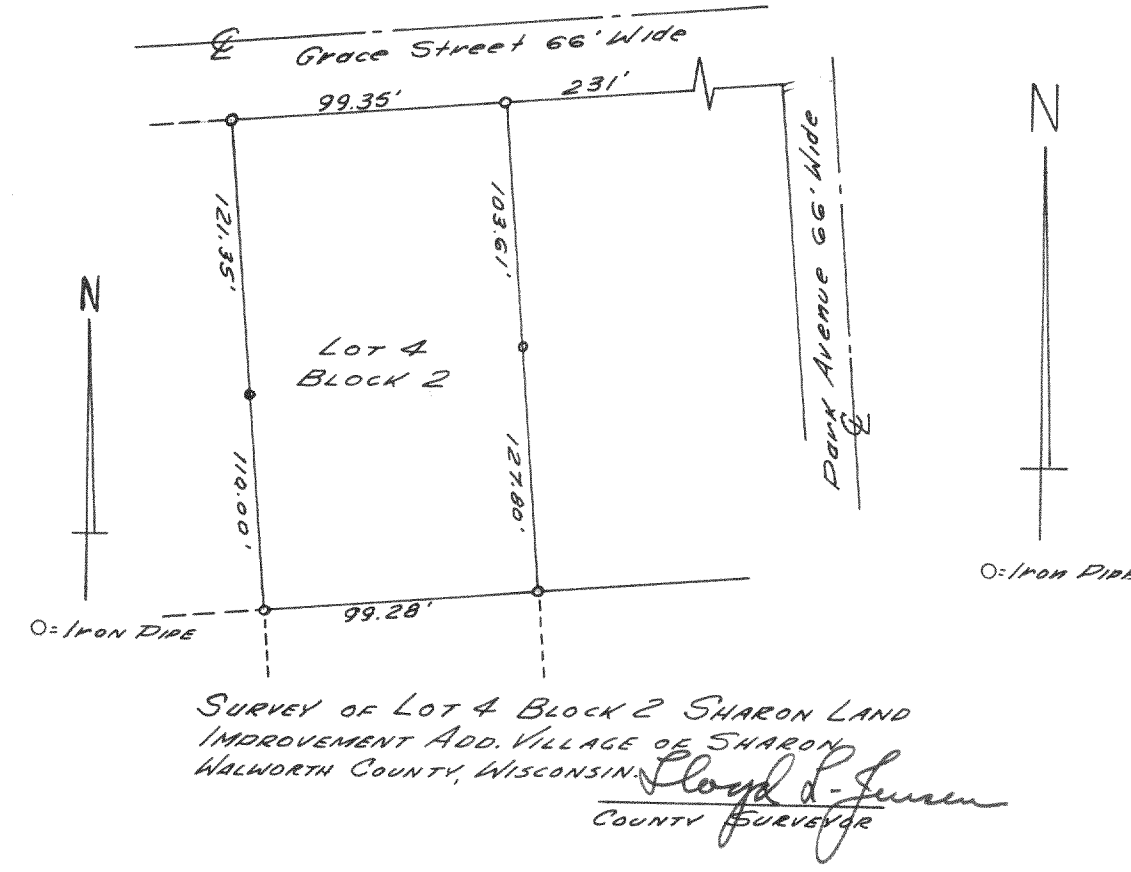


#3671

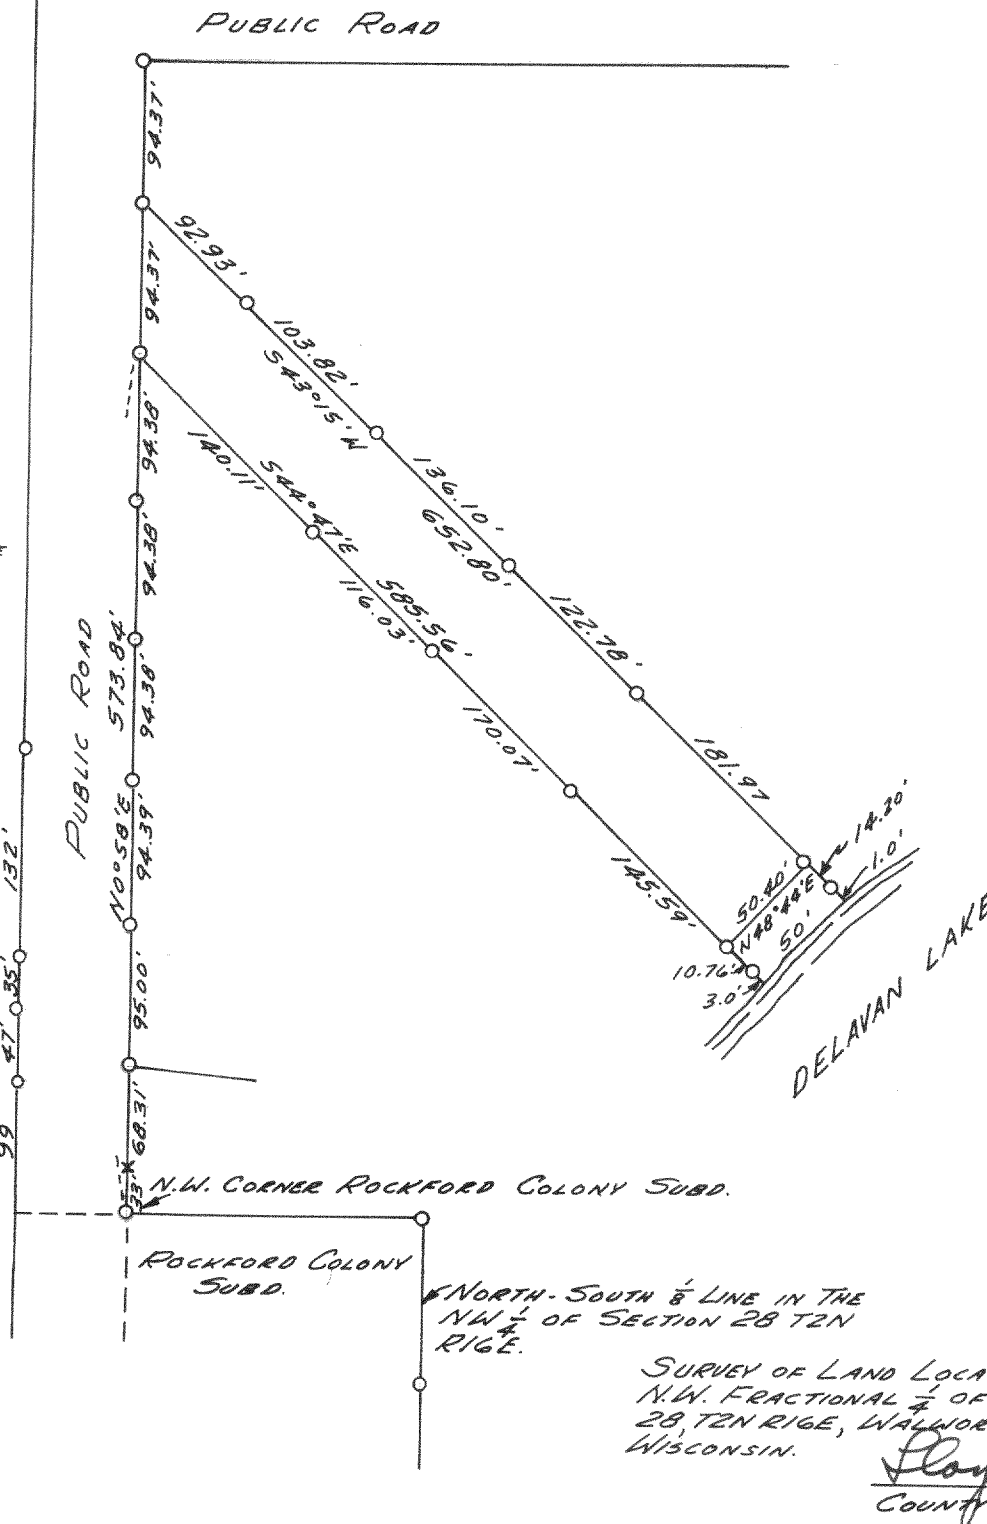


#3672

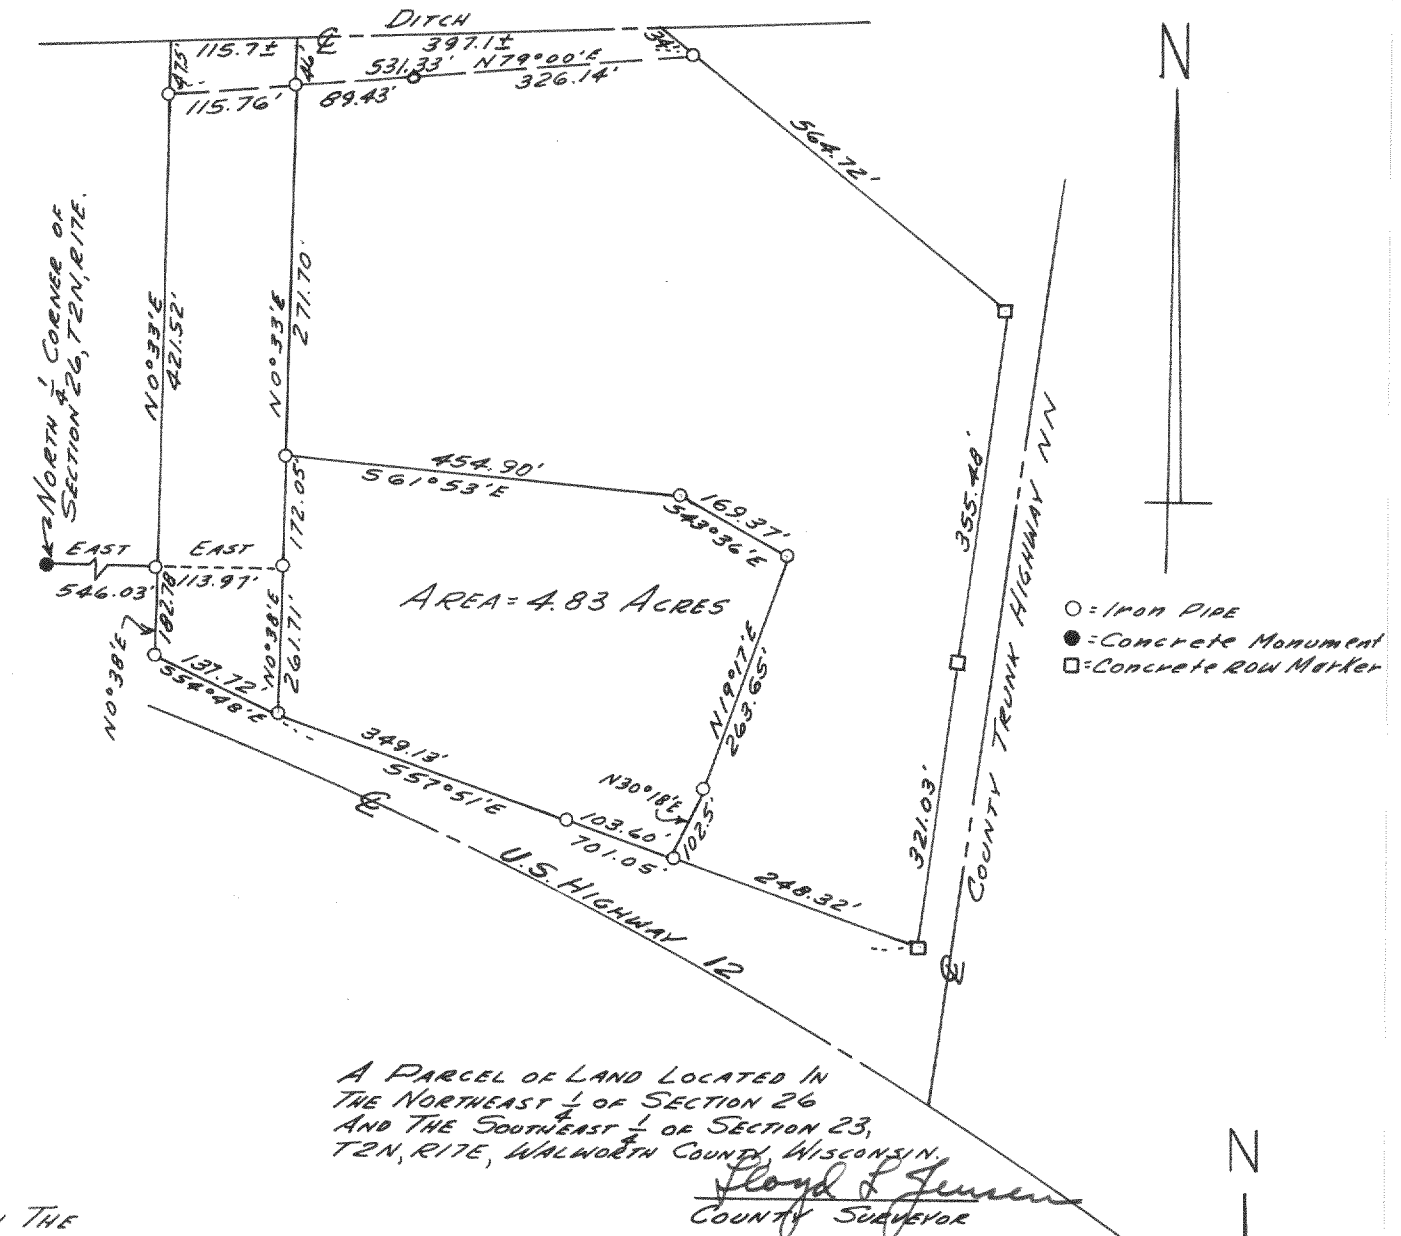

#3673

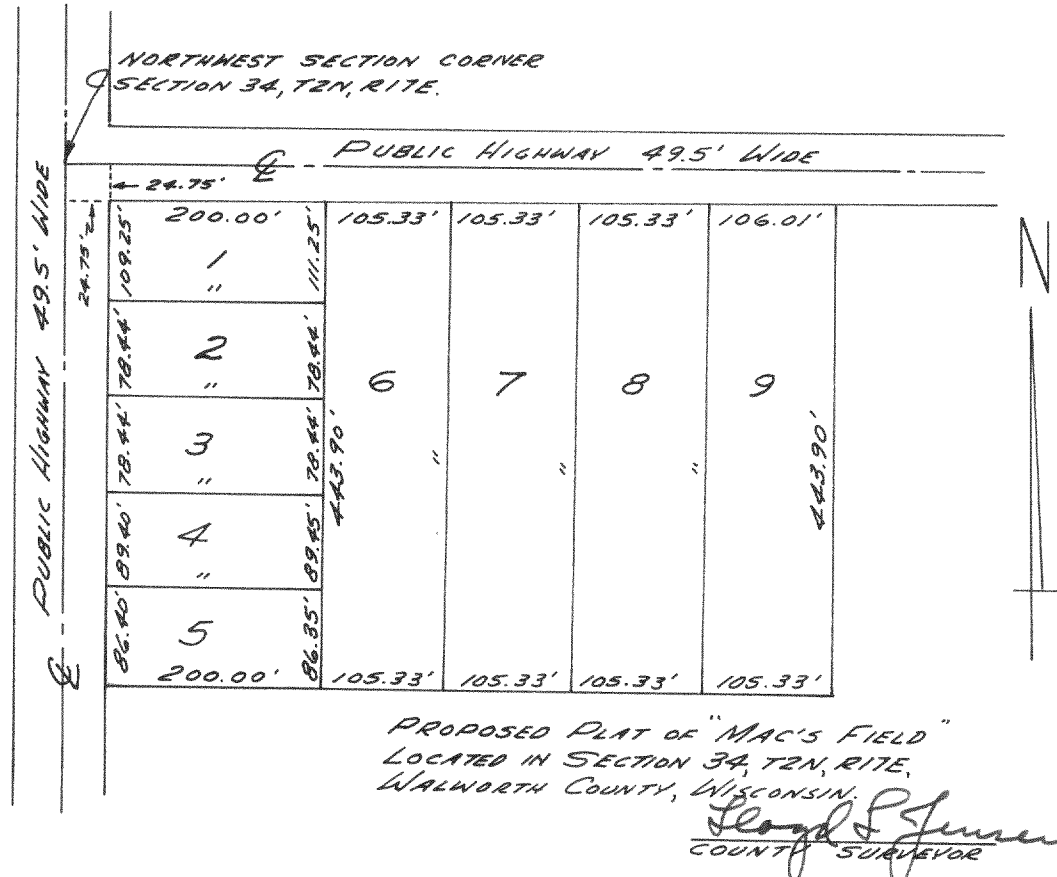

#3674

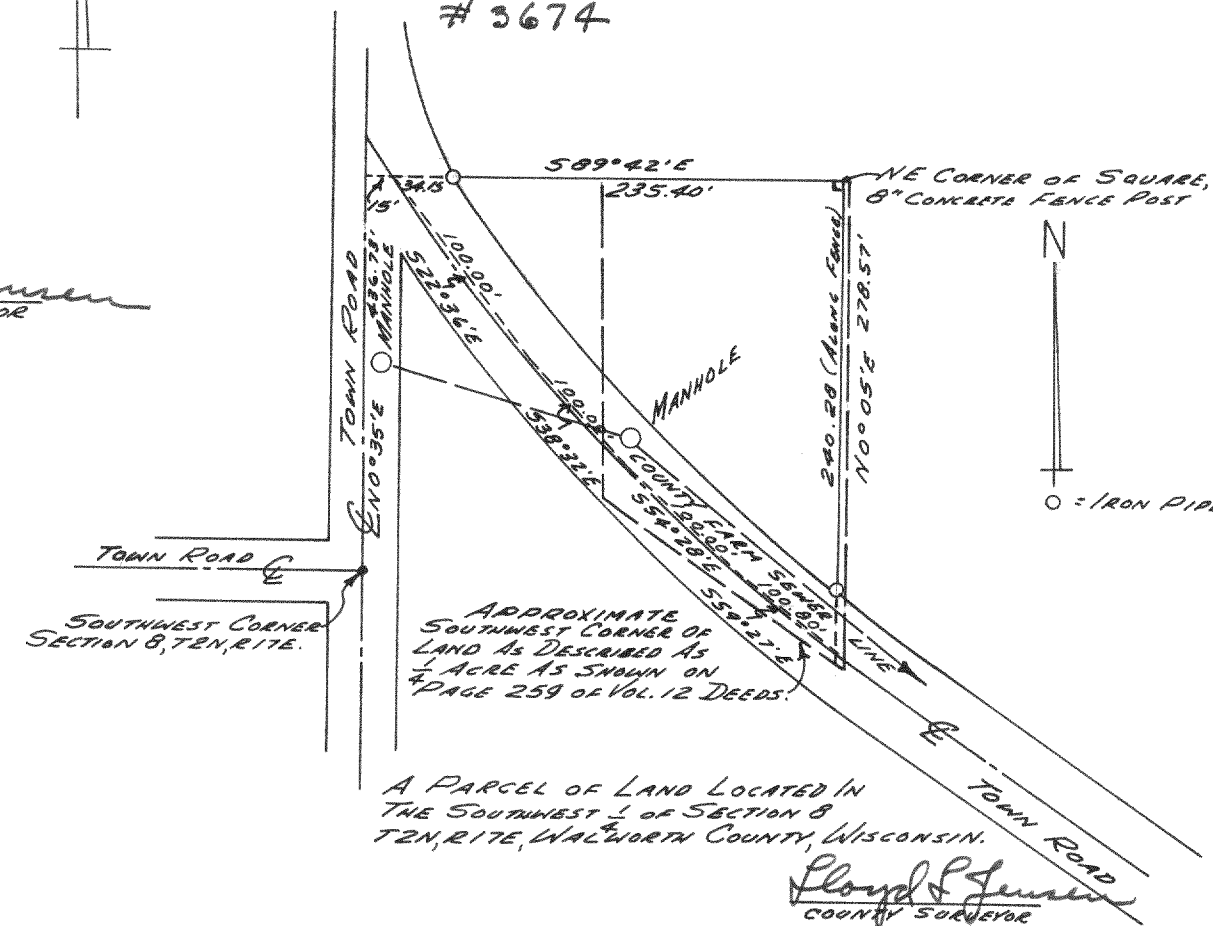

#3675

