#3683

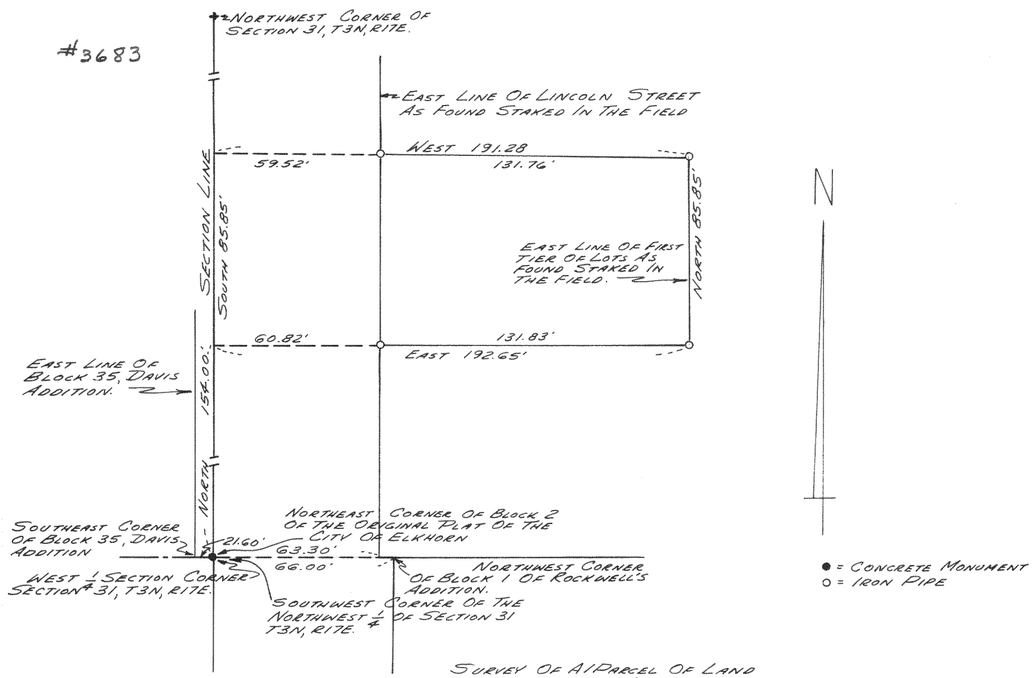

SURVEY OF A PARCEL OF LAND LOCATED IN THE NORTHWEST 1/4 OF SECTION 31, T3N, R17E, CITY OF ELKHORN

Floyd L Jensen
COUNTY SURVEYOR

#3684

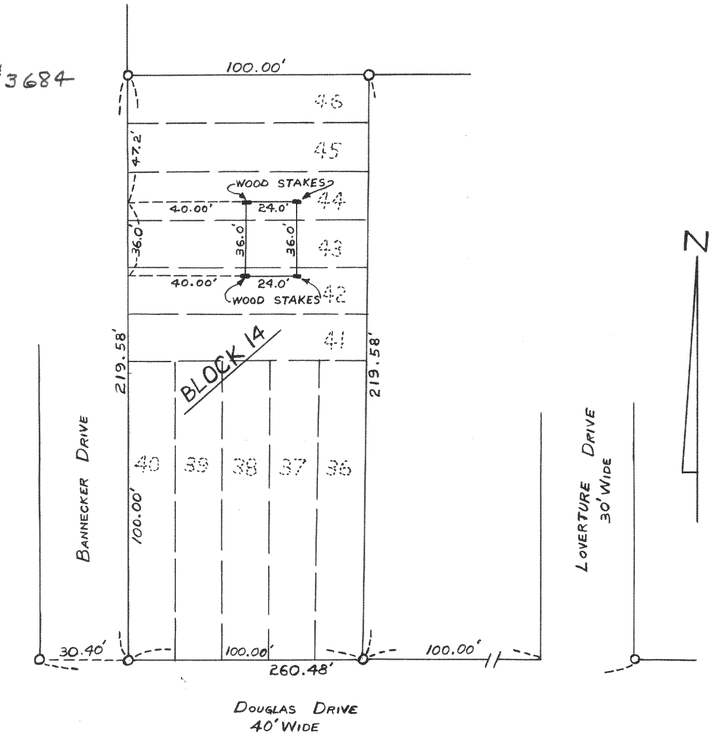

LOTS 36 TO 46, BLOCK 14, LAKE IVANHOE RESORT SECTION 2, T1N, R18E, WALWORTH COUNTY, WISCONSIN.

Floyd L Jensen
COUNTY SURVEYOR

#3685

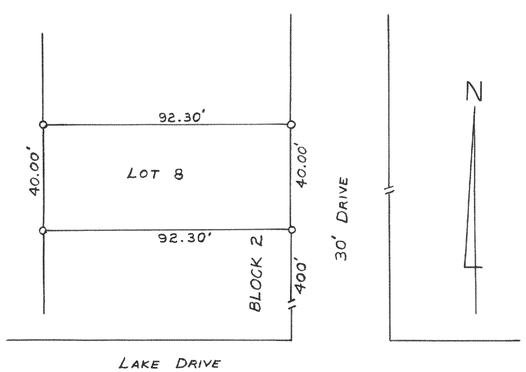

LOT 8, BLOCK 2, POTTER'S SUBDIVISION, LOCATED IN SECTION 32, T2N, R16E, WALWORTH COUNTY, WISCONSIN.

Floyd L Jensen
COUNTY SURVEYOR

#3686

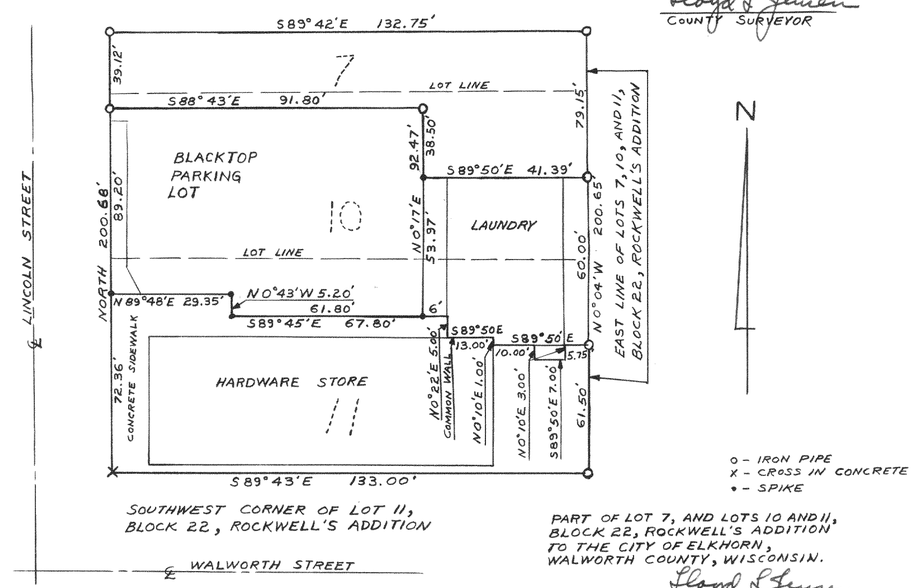

SOUTHWEST CORNER OF LOT 11, BLOCK 22, ROCKWELL'S ADDITION

PART OF LOT 7, AND LOTS 10 AND 11, BLOCK 22, ROCKWELL'S ADDITION TO THE CITY OF ELKHORN, WALWORTH COUNTY, WISCONSIN.

Floyd L Jensen
COUNTY SURVEYOR