
234


#3683

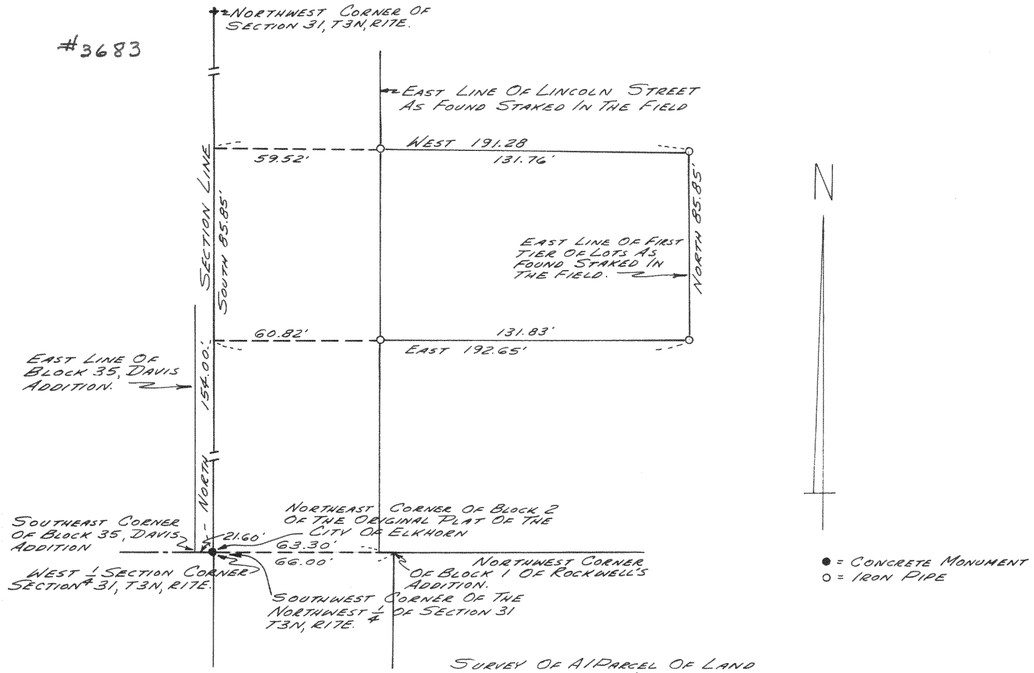


Survey Of A Parcel Of Land Located In The Northwest 1/4 Of Section 31, T3N, R17E, City Of Elkhorn

Floyd L Jensen
County Surveyor

#3684

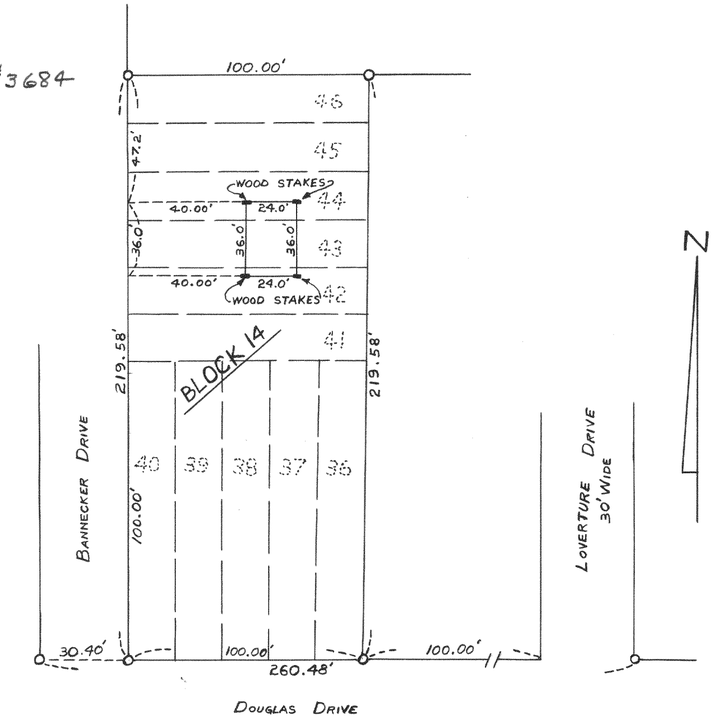

#3685

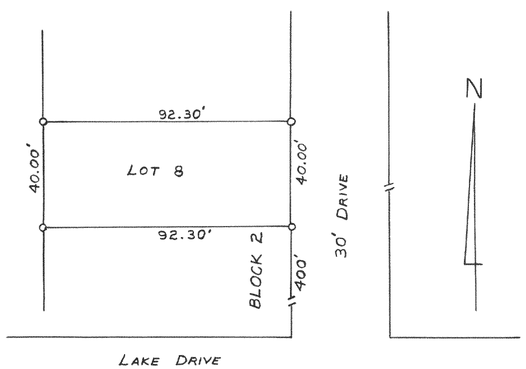


Lot 8, Block 2, Potter's Subdivision, Located In Section 32, T2N, R16E, Walworth County, Wisconsin.

Floyd L Jensen
County Surveyor

#3686


Floyd L Jensen
County Surveyor

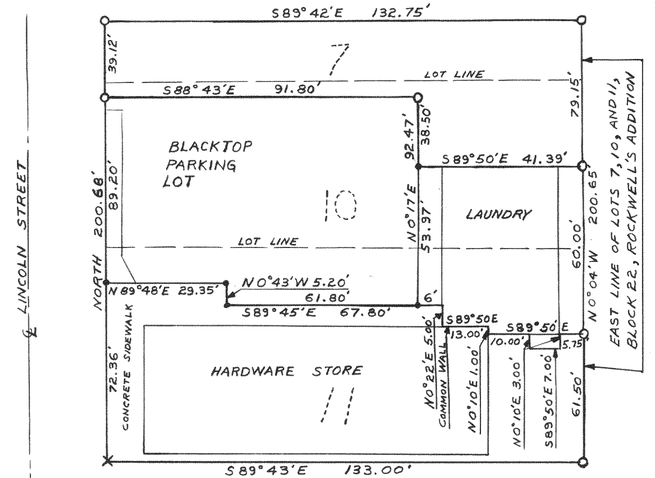

Southwest Corner Of Lot 11, Block 22, Rockwell's Addition

Part Of Lot 7, And Lots 10 And 11, Block 22, Rockwell's Addition To The City Of Elkhorn, Walworth County, Wisconsin.

Floyd L Jensen
County Surveyor