
#3687

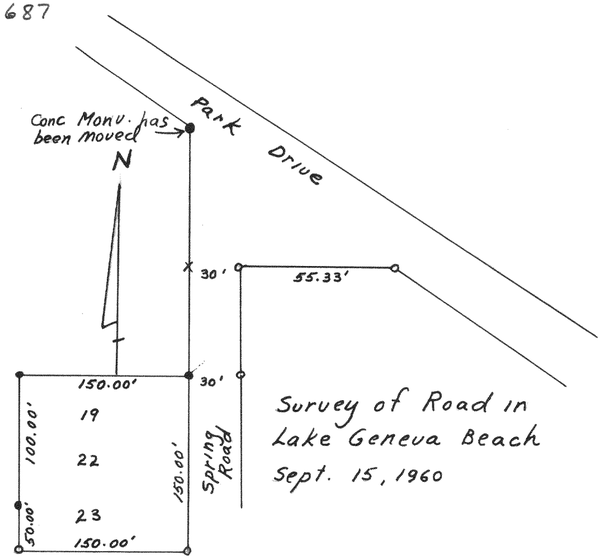


Survey of Road in Lake Geneva Beach Sept. 15, 1960

Survey of Lots 19, 22 & 23, Lake Geneva Beach Oct 6, 1960

Lloyd L Jensen
County Surveyor


#3688

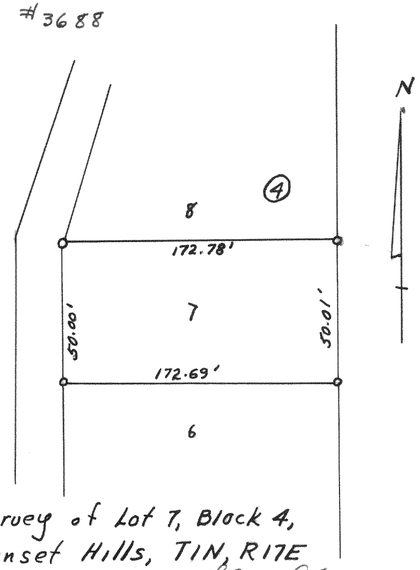

Survey of Lot 7, Block 4, Sunset Hills, T1N, R17E
June 21, 1961

Lloyd L Jensen
County Surveyor

#3689

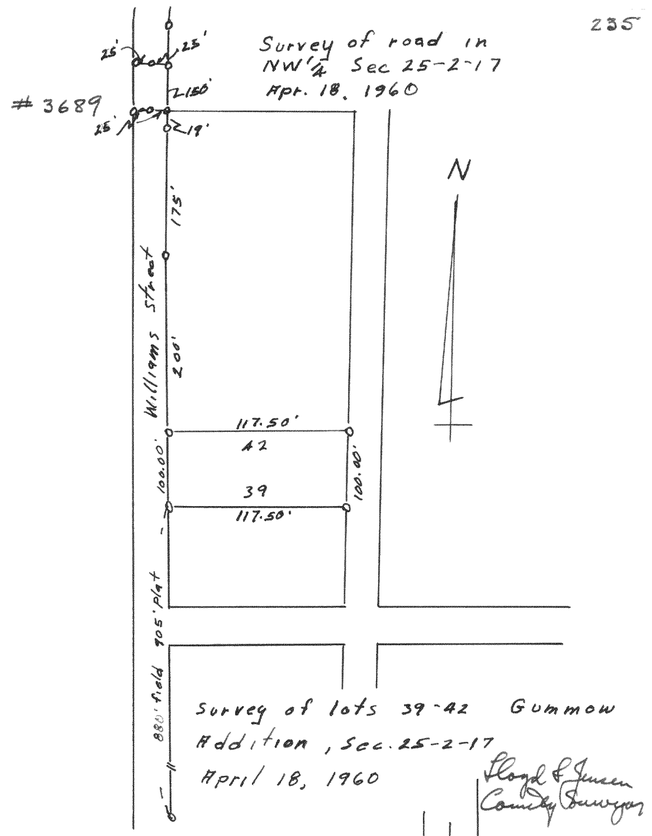


Survey of road in NW¼ Sec 25-2-17
Apr. 18, 1960

Survey of lots 39-42 Gummow Addition, Sec. 25-2-17
April 18, 1960

Lloyd L Jensen
County Surveyor


#3690

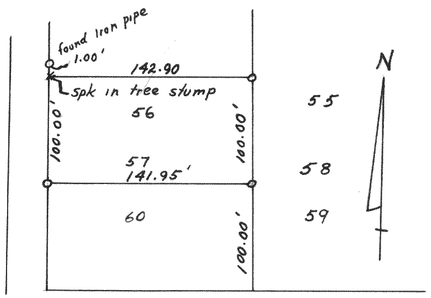

Survey of Lots 56 & 57, Lake Geneva Beach
Oct 6, 1960

Lloyd L Jensen
County Surveyor


#3691

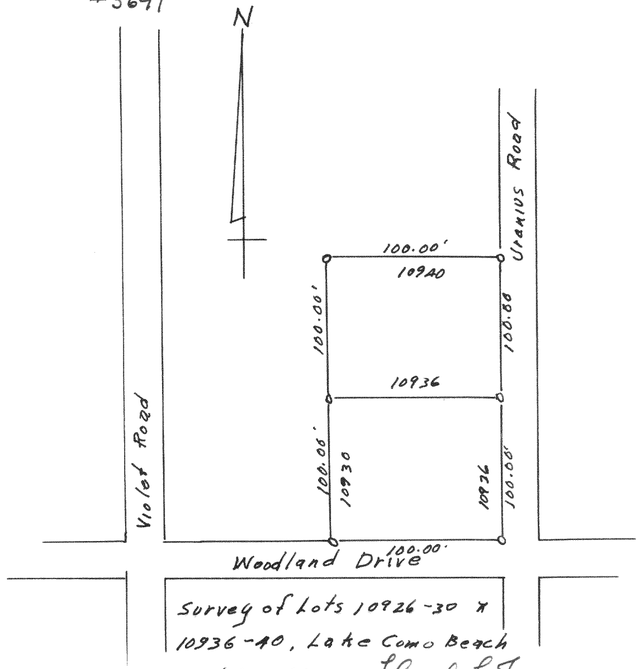

Survey of Lots 10926-30 & 10936-40, Lake Como Beach
April 6, 1960

Lloyd L Jensen
County Surveyor

#3692

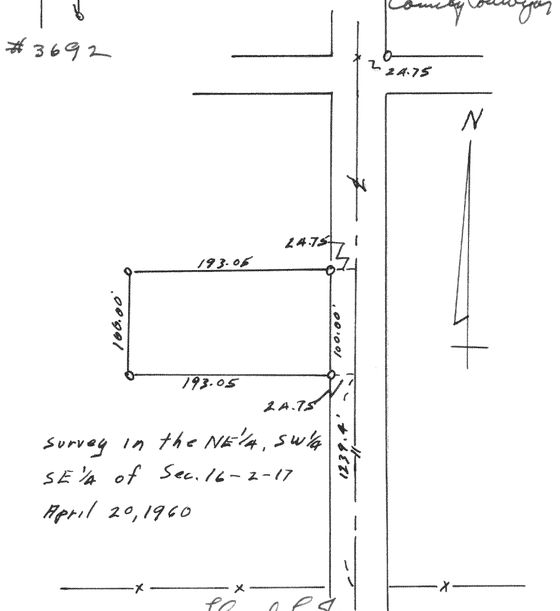

Survey in the NE¼, SW¼ SE¼ of Sec. 16-2-17
April 20, 1960

Lloyd L Jensen
County Surveyor