

# 2700

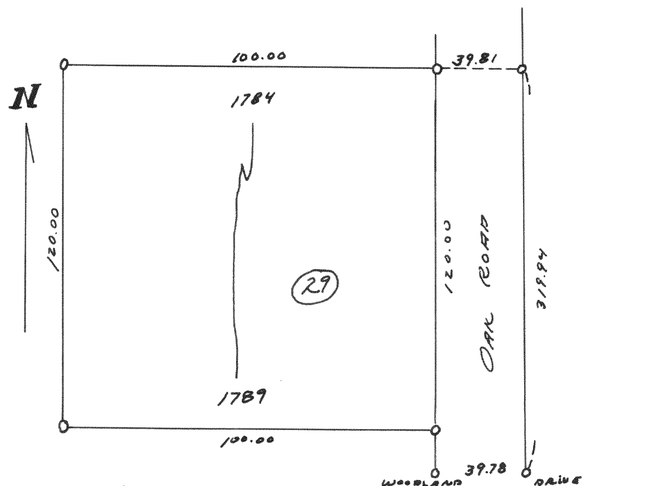


Plat of Survey of Lots 1784-1789 (INCL)
Block 29 Lake Como Beach T2NR17E
April, 1953

LLJ
CS


# 2701

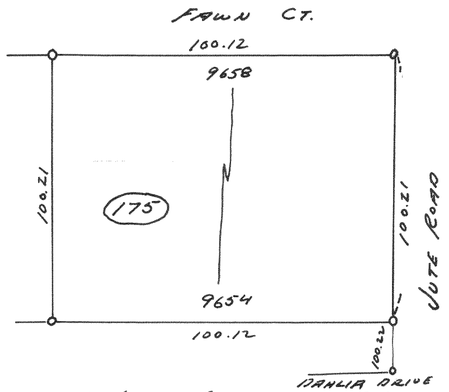


Plat of Survey of Lots 9654-9658 (INCL)
Block 175 4th Map Lake Como Beach
T2NR17E
May 23, 1953

LLJ
CS


# 2702

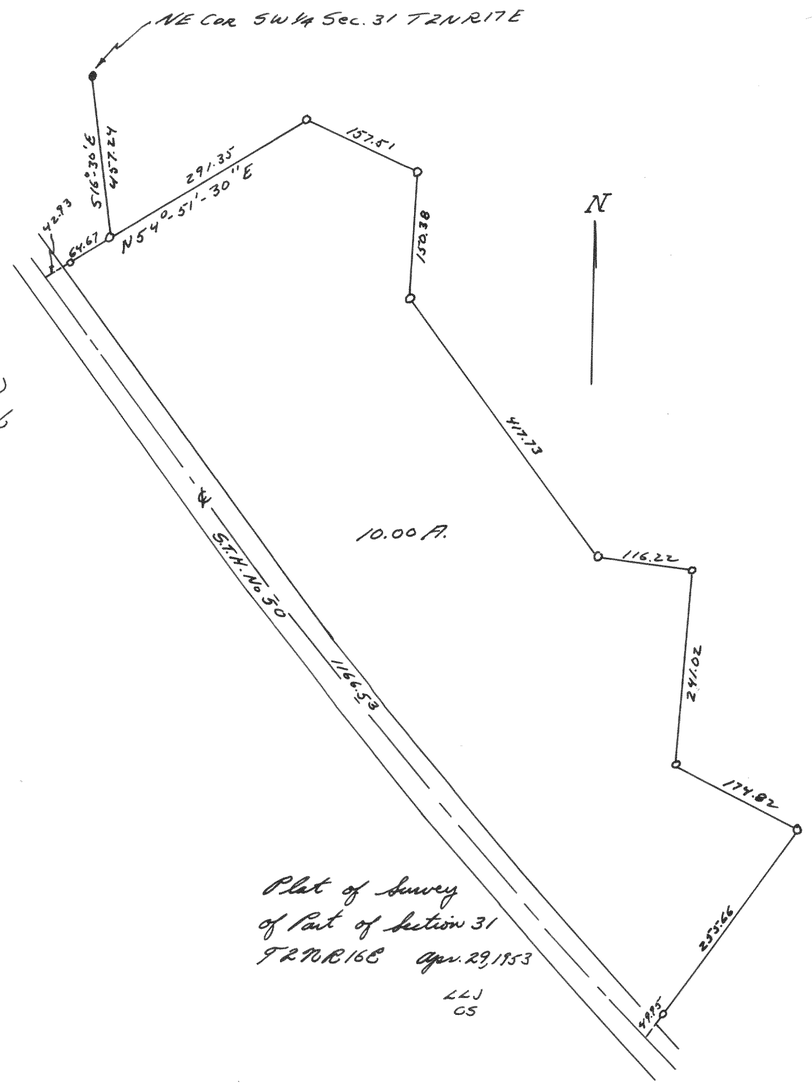


Plat of Survey
of Part of Section 31
T2NR16E Apr. 29, 1953

LLJ
CS


# 2703

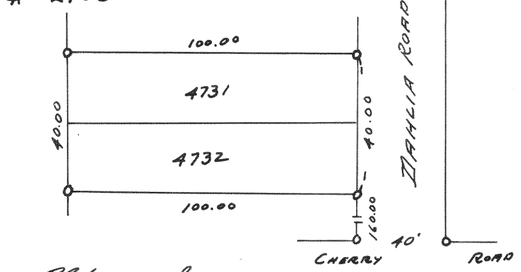


Plat of Survey of
Lots 4731 & 4732 4th Map
Lake Como Beach T2NR17E
May 1953

LLJ
CS

# 2704

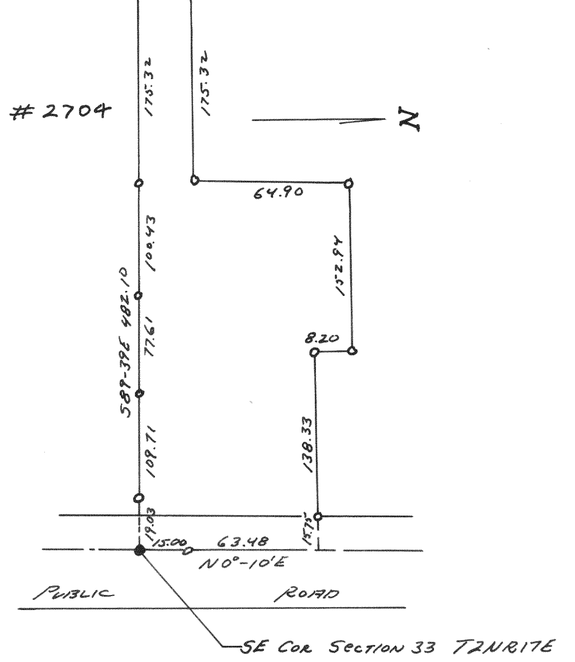


Plat of Survey of Land Located
in SE¼ Section 33 T2NR17E
May 1953

LLJ
CS