

#3724

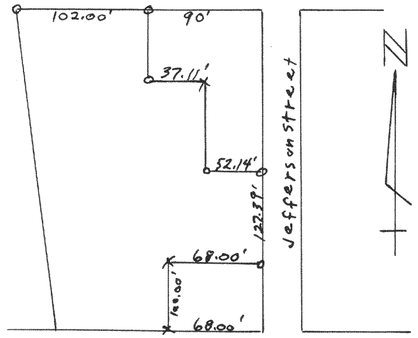

Plat of Survey of A Parcel of land located in William Birges Add. to the City of Whitewater, Walworth county Wisconsin, Aug 1959

Lloyd L Jensen
county Surveyor


#3725

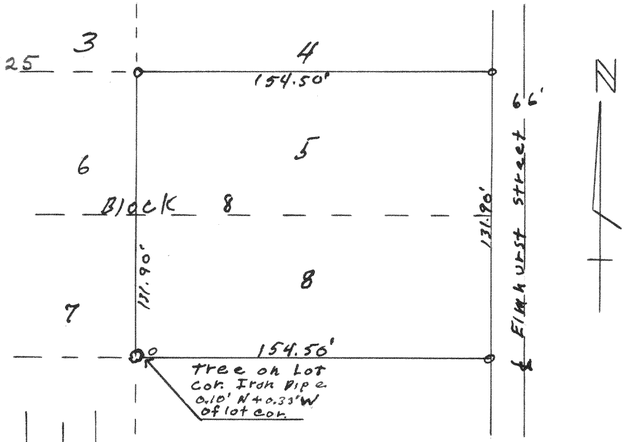

Plat of survey of
Lots 5 & 8, Block 8, Williams
1st Add. to Williams Bay
Walworth county Wisconsin
July 1959

Lloyd L. Jensen
County Surveyor


#3726

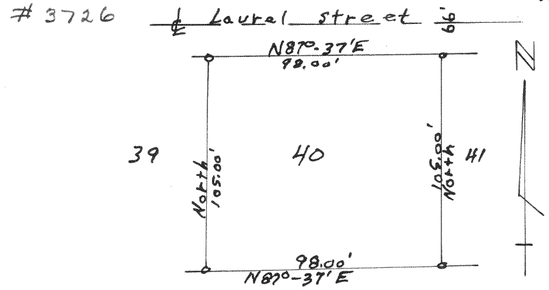

Plat of Survey of
Lot 40 West Park Add.
City of Whitewater,
Walworth County Wisconsin
Aug 1959

Lloyd L. Jensen
county surveyor


#3727

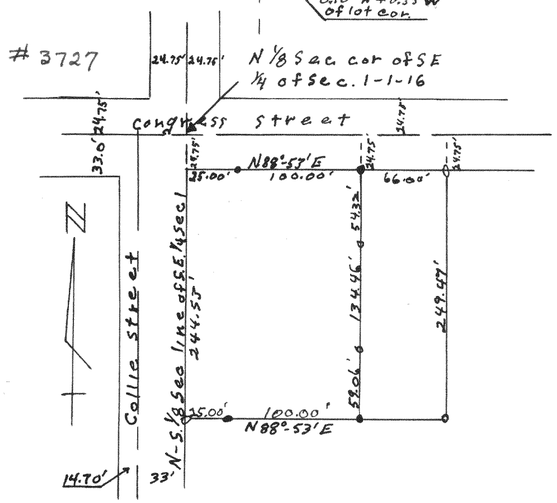

Plat of Survey of the East 66' of the West 191' of lands sold by Holmquist to Soderberg in the N.E. 1/4 of the S.E. 1/4 of sec. 1, T1N, R16E, Village of Wms. Bay Walworth County Wisc.
Oct. 1959

Lloyd L. Jensen
County surveyor

#3728

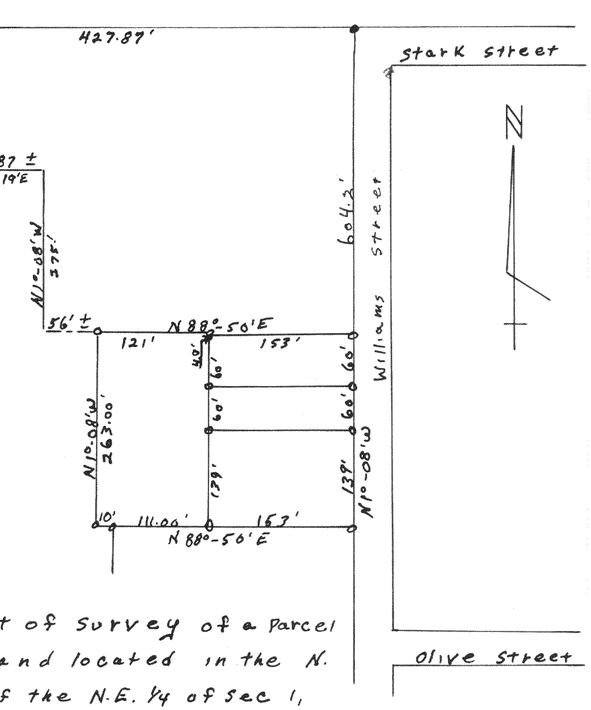

Plat of survey of a parcel of land located in the N. 1/2 of the N.E. 1/4 of sec 1, T1N, R16E, Village of Wms Bay, Walworth County Wisc.
Jan 1960

Lloyd L. Jensen
County Surveyor