#3724

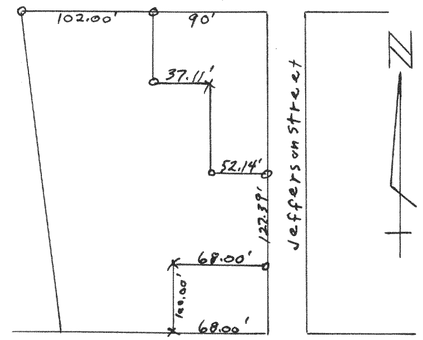

Plat of Survey of A Parcel of land located in William Birges Add. to the City of Whitewater, Walworth county Wisconsin, Aug 1959

Lloyd L Jensen
county Surveyor

#3725

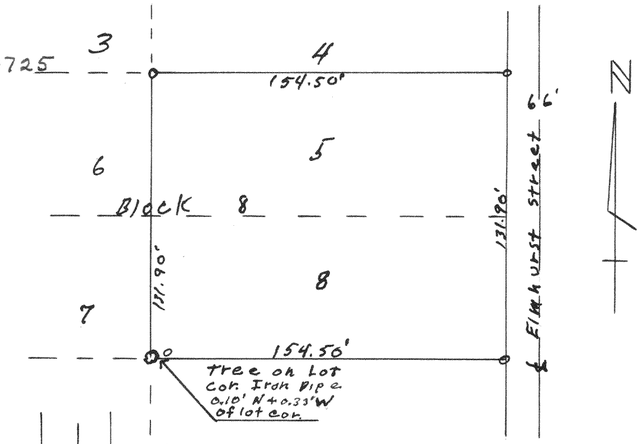

Plat of survey of Lots 5 + 8, Block 8, Williams 1st Add. to Williams Bay Walworth county Wisconsin July 1959

Lloyd L. Jensen
county surveyor

#3726

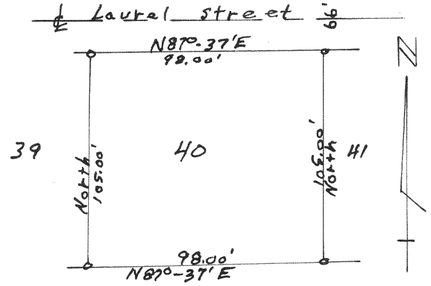

Plat of Survey of Lot 40 West Park Add. City of Whitewater, Walworth County Wisconsin Aug 1959

Lloyd L. Jensen
county surveyor

#3727

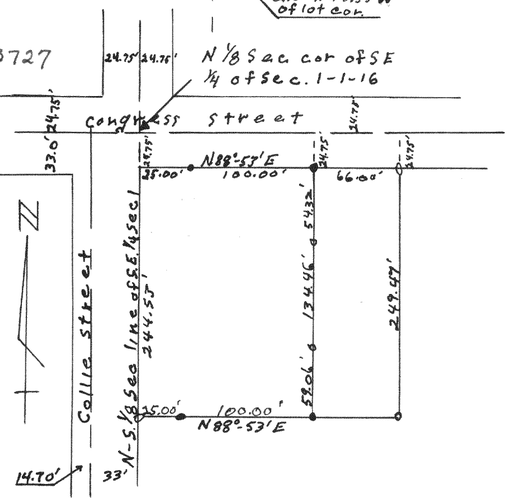

Plat of Survey of the East 66' of the West 191' of lands sold by Holmquist to Soderberg in the N.E. 1/4 of the S.E. 1/4 of Sec. 1, T1N, R16E, Village of Wms. Bay Walworth county Wisc. Oct. 1959

Lloyd L. Jensen
county surveyor

#3728

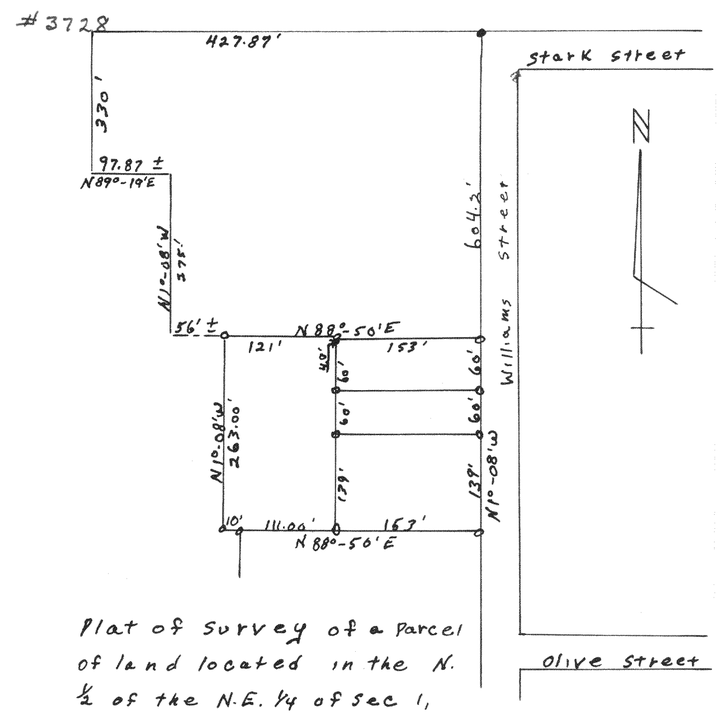

Plat of survey of a parcel of land located in the N. 1/2 of the N.E. 1/4 of sec 1, T1N, R16E, Village of Wms Bay, Walworth County Wisc. Jan 1960

Lloyd L. Jensen
county surveyor