

#3733

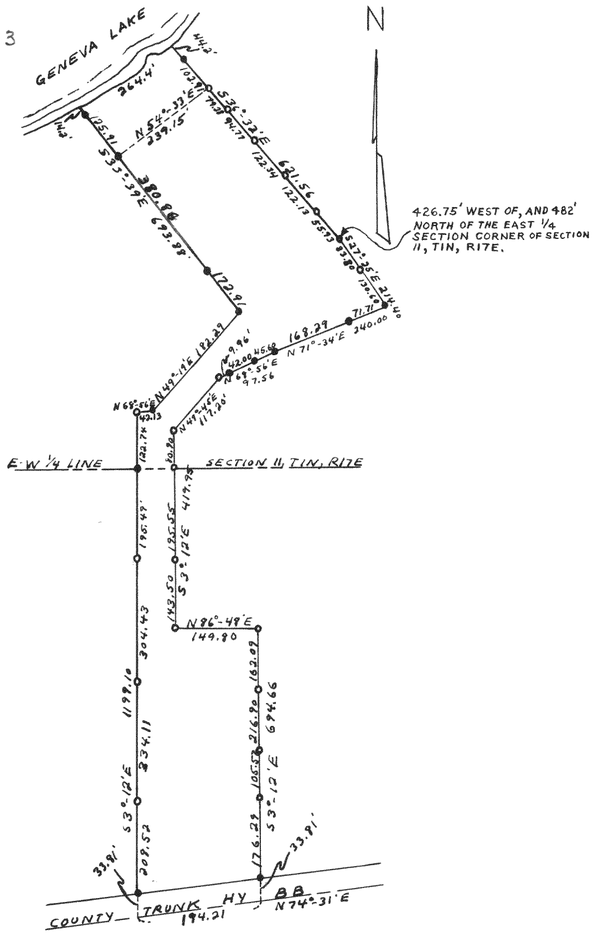

PLAT OF SURVEY OF A PARCEL OF LAND LOCATED IN THE EAST ½ OF SECTION 11, T1N, R17E, WALWORTH COUNTY, WISCONSIN.

MAY, 1958 Floyd L. Jensen
COUNTY SURVEYOR


#3734

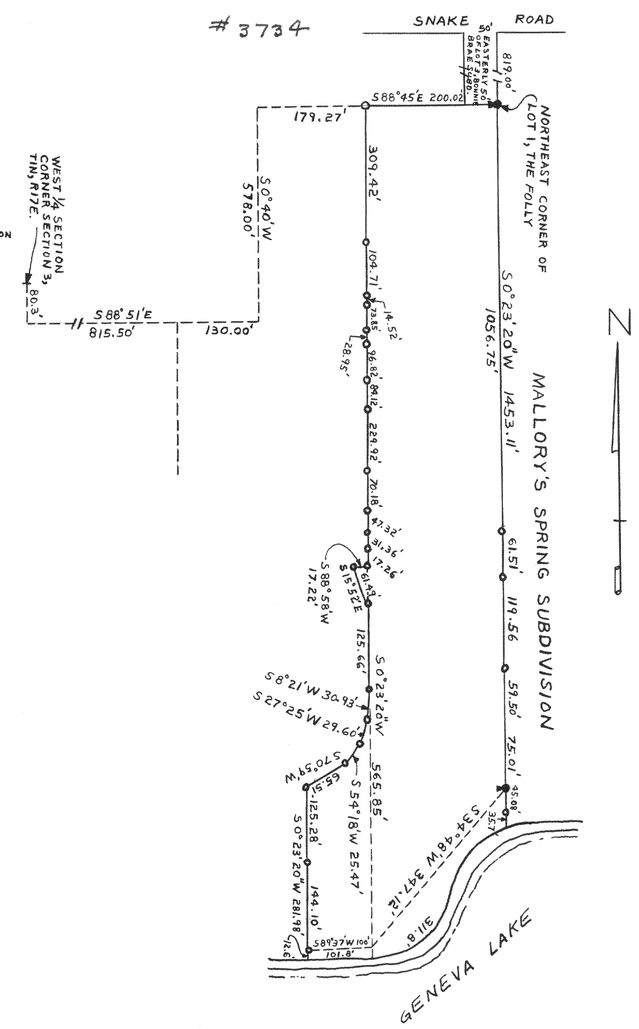

PLAT OF SURVEY OF PART OF LOT 1 OF "THE FOLLY", LOCATED IN SECTION 3, T1N, R17E, WALWORTH COUNTY, WISCONSIN.

OCTOBER, 1960 Floyd L. Jensen
COUNTY SURVEYOR

#3735

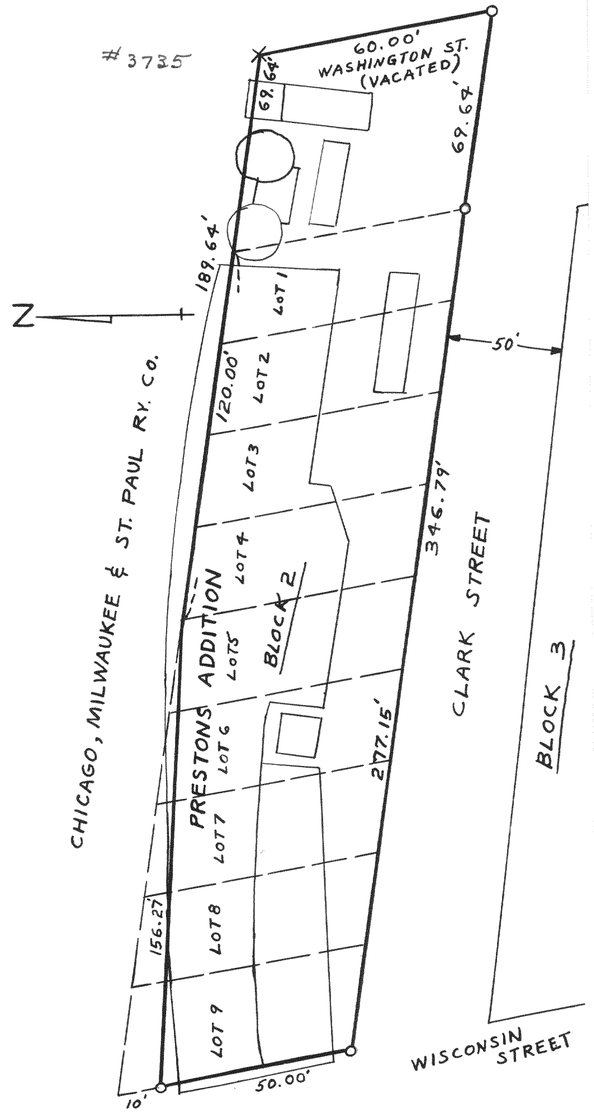

PLAT OF SURVEY OF BLOCK 2, PRESTONS ADDITION AND PART OF WASHINGTON STREET (VACATED), CITY OF ELKHORN, WALWORTH COUNTY, WISCONSIN.

MARCH 14, 1961 Floyd L. Jensen
COUNTY SURVEYOR