

#3739

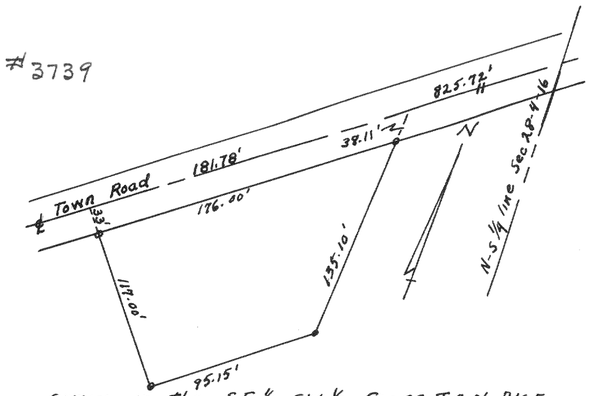

Survey in the SE¼ SW¼ Sec 28, T 4 N, R 16 E, Wal. Co. Wisc.

Lloyd L. Jensen
County Surveyor


#3740

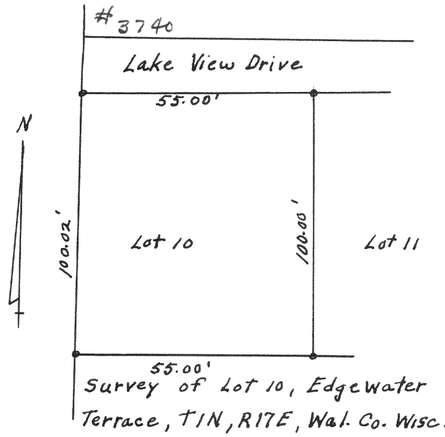

Survey of Lot 10, Edgewater Terrace, T 1 N, R 17 E, Wal. Co. Wisc.

Lloyd L. Jensen
County Surveyor


#3741

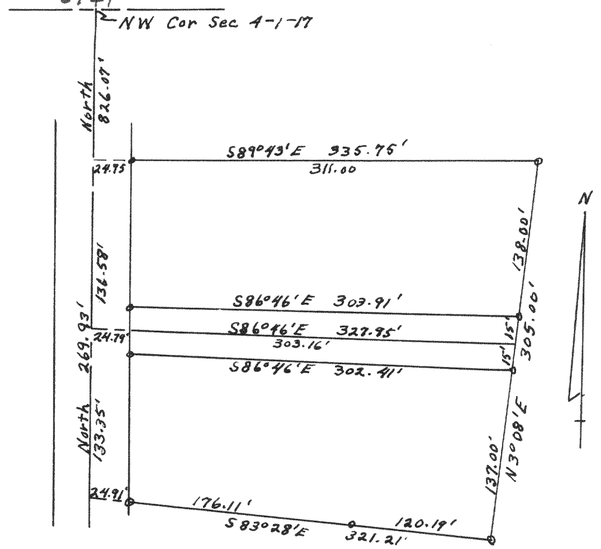

Survey in NW¼ NW¼ Fractional Sec 4, T 1 N, R 17 E Wal. Co. Wisc.

Lloyd L. Jensen
County Surveyor


#3742

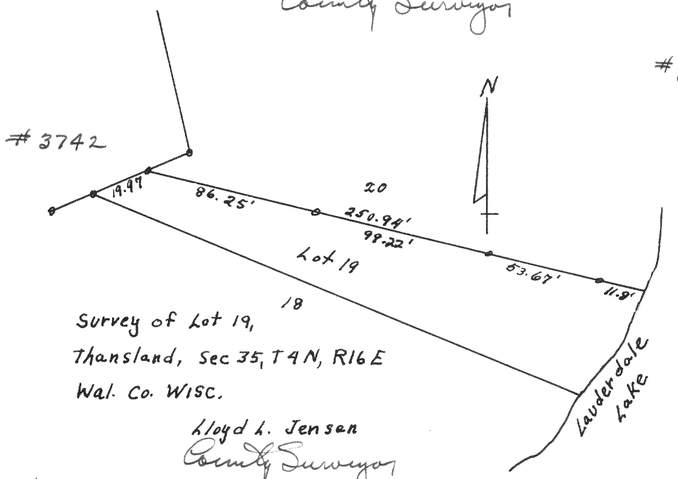

Survey of Lot 19, Thansland, Sec 35, T 4 N, R 16 E Wal. Co. Wisc.

Lloyd L. Jensen
County Surveyor


#3743

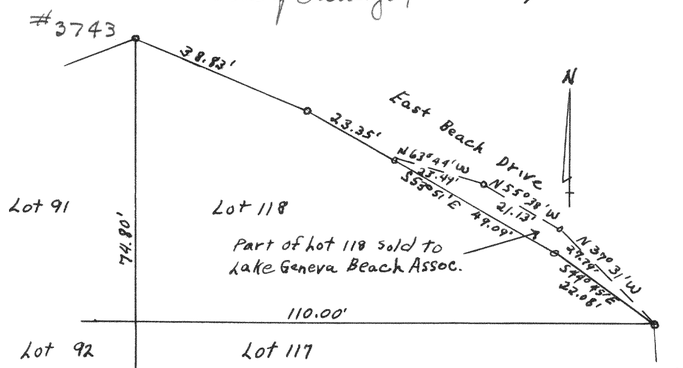

Survey of Lot 118, Lake Geneva Beach Subd, SW¼ Sec. 11, T 1 N, R 17 E Wal. Co. Wisc.

Lloyd L. Jensen
County Surveyor


#3744

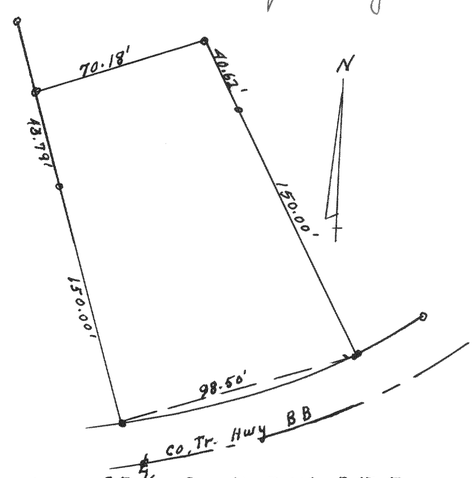

Survey in SE¼ Sec 11, T 1 N, R 17 E, Wal. Co. Wisc.

Lloyd L. Jensen
County Surveyor


#3745

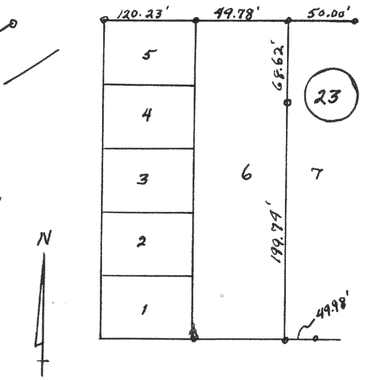

Survey of Lot 6, Blk 23 Sunset Hills Subd, T 1 N, R 17 E, Wal. Co. Wisc.

Lloyd L. Jensen
County Surveyor

#3746

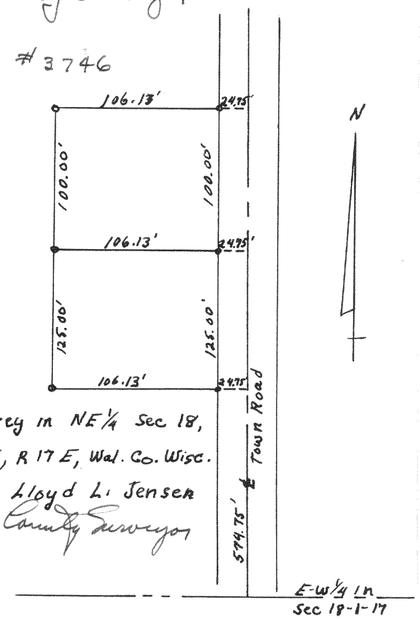

Survey in NE¼ Sec 18, T 1 N, R 17 E, Wal. Co. Wisc.

Lloyd L. Jensen
County Surveyor