

#3747

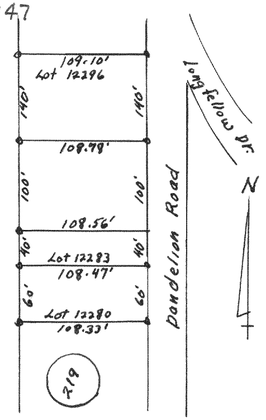

Survey Lots 12280 - 12296, Blk 219, Lake Como Beach, T2N, R17E, Wal. Co. Wisc.

Lloyd L. Jensen
County Surveyor


#3748

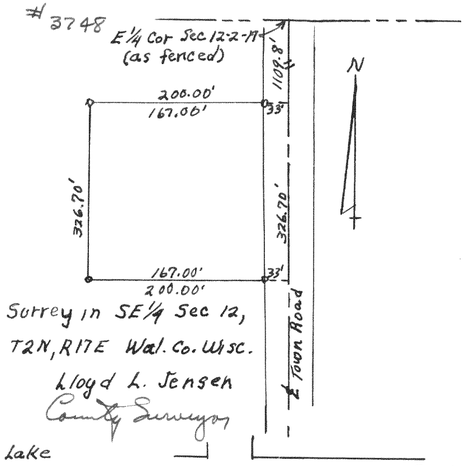

Survey in SE¼ Sec 12, T2N, R17E Wal. Co. Wisc.

Lloyd L. Jensen
County Surveyor


#3749

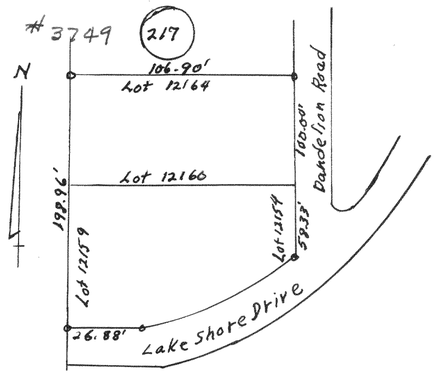

Survey of Lots 12154-64, Blk 217, Lake Como Beach, T2N, R17E, Wal. Co. Wisc.

Lloyd L. Jensen
County Surveyor


#3750

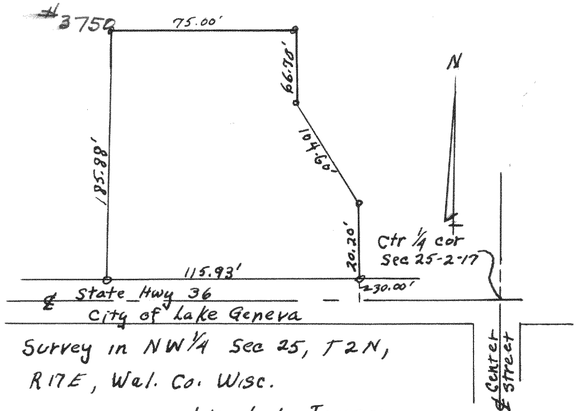

Survey in NW¼ Sec 25, T2N, R17E, Wal. Co. Wisc.

Lloyd L. Jensen
County Surveyor


#3751

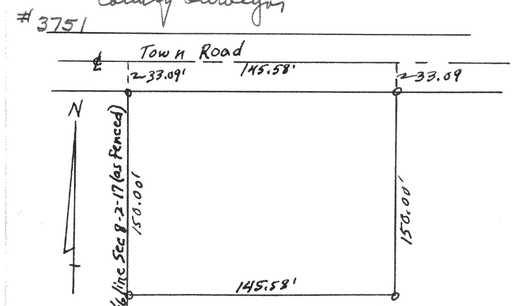

Survey in NE¼ NW¼ Sec 8, T2N, R17E, Wal. Co. Wisc.

Lloyd L. Jensen
County Surveyor


#3752

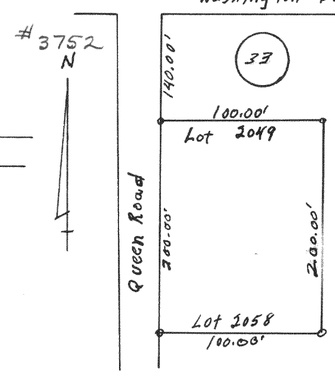

Survey of Lots 2049-58 Blk 33 Lake Como Beach, T2N, R17E, Wal. Co. Wisc.

Lloyd L. Jensen
County Surveyor


#3753

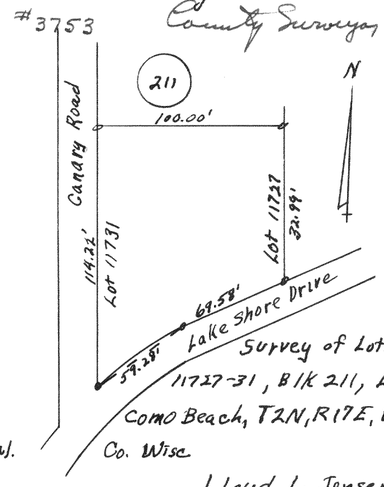

Survey of Lots 11727-31, Blk 211, Lake Como Beach, T2N, R17E, Wal. Co. Wisc.

Lloyd L. Jensen
County Surveyor


#3754

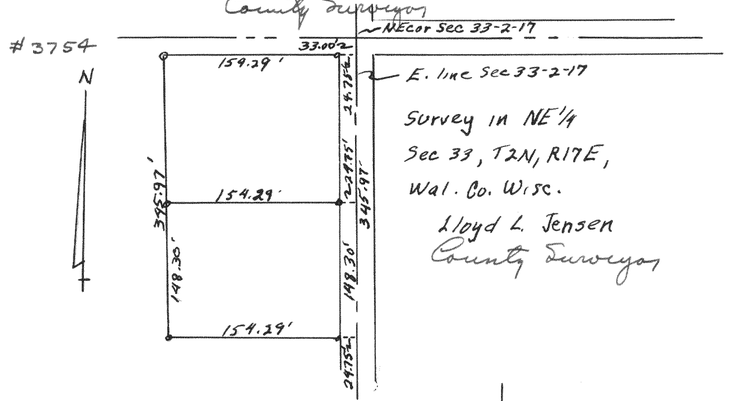

Survey in NE¼ Sec 33, T2N, R17E, Wal. Co. Wisc.

Lloyd L. Jensen
County Surveyor


#3755

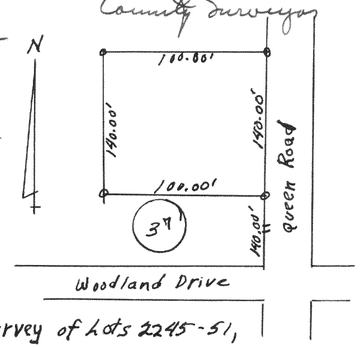

Survey of Lots 2245-51, Blk 37, Lake Como Beach, T2N, R17E, Wal. Co. Wisc.

Lloyd L. Jensen


#3756

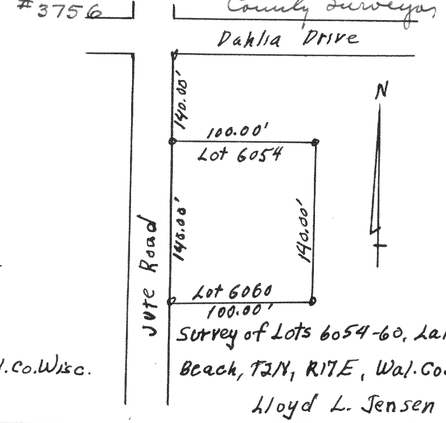

Survey of Lots 6054-60, Lake Como Beach, T2N, R17E, Wal. Co. Wisc.

Lloyd L. Jensen


#3757

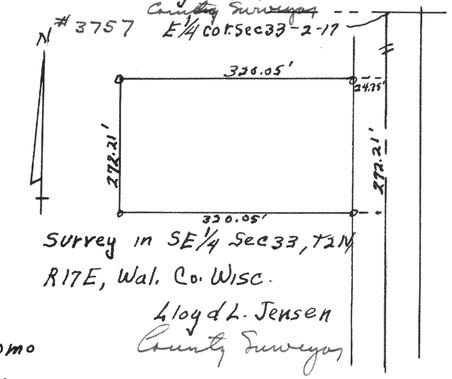

Survey in SE¼ Sec 33, T2N, R17E, Wal. Co. Wisc.

Lloyd L. Jensen
County Surveyor

#3758

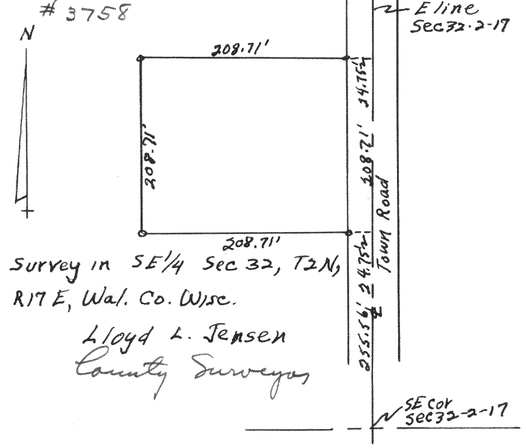

Survey in SE¼ Sec 32, T2N, R17E, Wal. Co. Wisc.

Lloyd L. Jensen
County Surveyor