

#3759

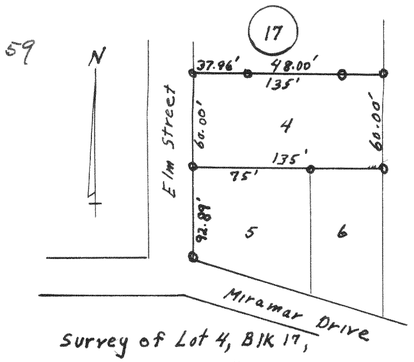

Survey of Lot 4, Blk 17, Miramar Add. #1, T4N, R18E, Wal. Co. Wisc.

Lloyd L. Jensen
County Surveyor


#3760

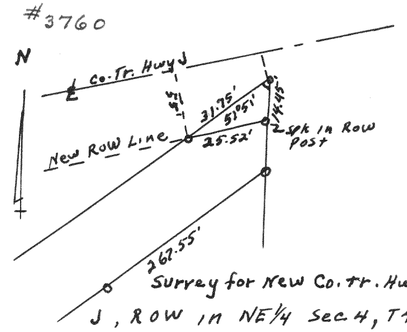

Survey for New Co. Tr. Hwy J, ROW in NE¼ Sec 4, T4N, R18E, Wal. Co. Wisc.

Lloyd L. Jensen
County Surveyor


#3761

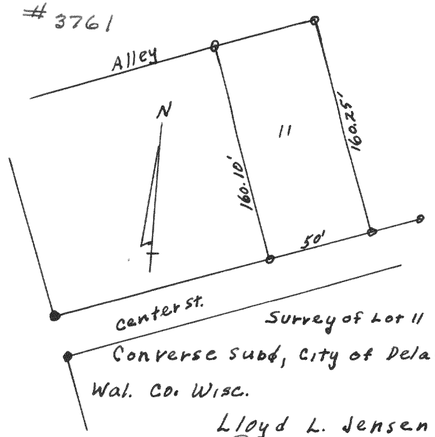

Survey of Lot 11 Converse Subd, City of Delavan Wal. Co. Wisc.

Lloyd L. Jensen
County Surveyor


#3762

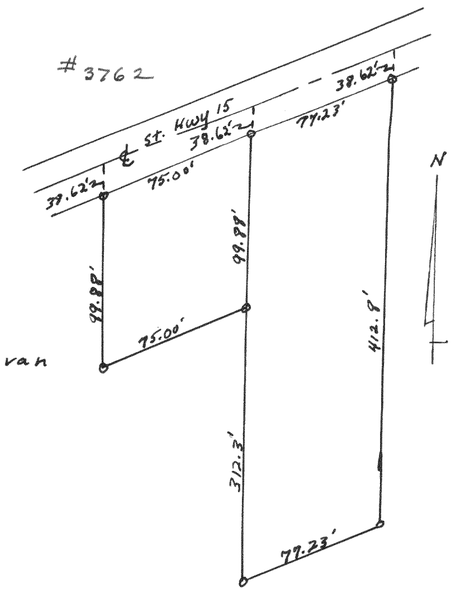

Survey in Sec 20, Vil. of East Troy Wal. Co. Wisc.

Lloyd L. Jensen
County Surveyor


#3763

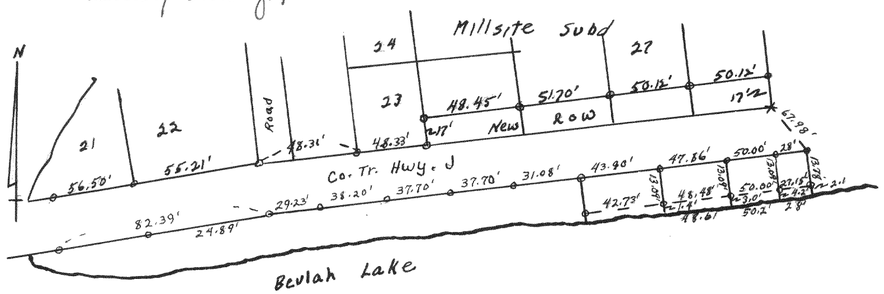

Survey of Co. Tr. Hwy J thru Millsite Subd, T4N, R18E, Wal. Co. Wisc.

Lloyd L. Jensen
County Surveyor


#3764

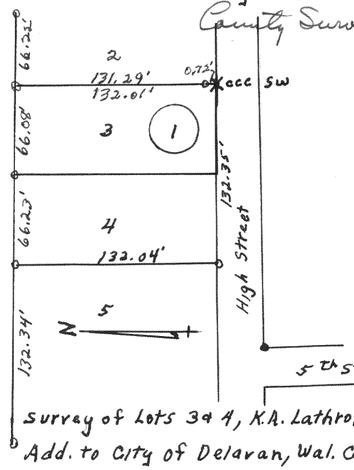

Survey of Lots 3 & 4, K.A. Lathrop's Add. to City of Delavan, Wal. Co. Wisc.

Lloyd L. Jensen
County Surveyor


#3765

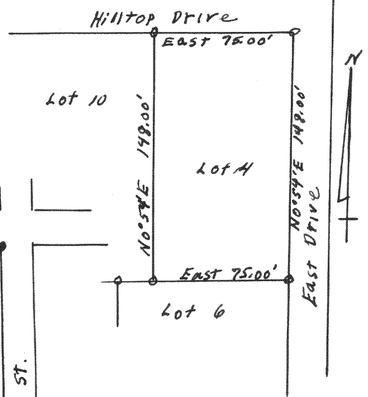

Survey of Lot 11, Lynndale Subd, Vil. of East Troy, Wal. County, Wisc.

Lloyd L. Jensen
County Surveyor


#3766

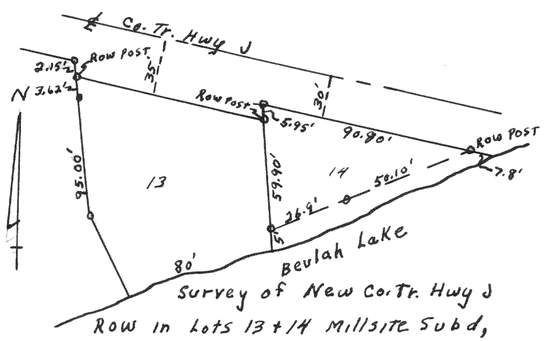

Survey of New Co. Tr. Hwy J Row in Lots 13 & 14 Millsite Subd, T4N, R18E, Wal. Co. Wisc.

Lloyd L. Jensen
County Surveyor


#3767

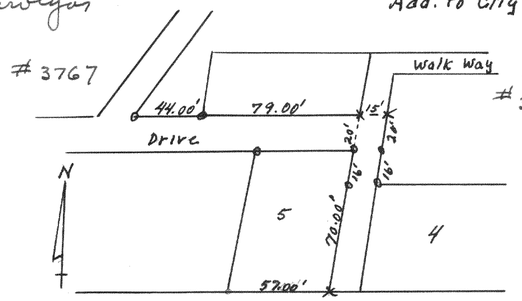

Survey of Walk way at Lot 5, a subd of Lots 13 & 14 of Romadka Park, T4N, R18E, Wal. Co. Wisc.

Lloyd L. Jensen
County Surveyor

#3768

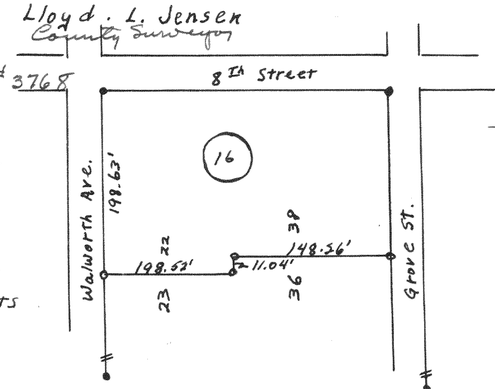

Survey of Park of Block 16, Passage, Aram & Downies Subd, City of Delavan, Wal. Co. Wisc.

Lloyd L. Jensen