

2705

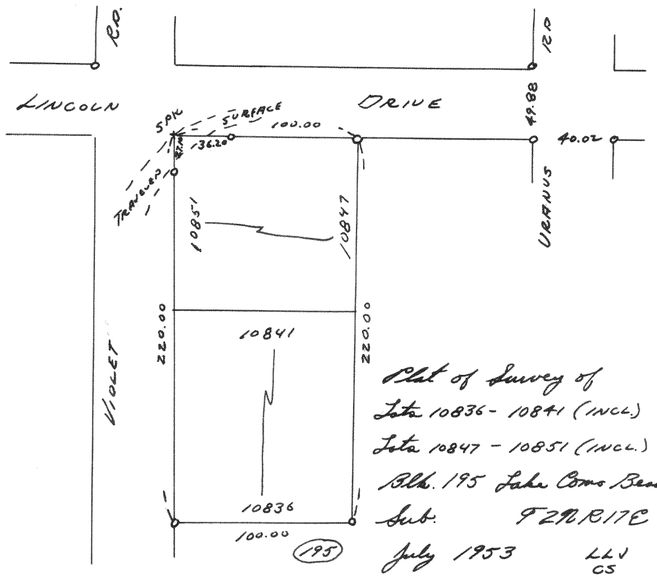


Plat of Survey of
Lots 10836 - 10841 (INCL.)
Lots 10847 - 10851 (INCL.)
Blk. 195 Lake Como Beach
Sub. T29NR17E
July 1953 LLJ CS

2706

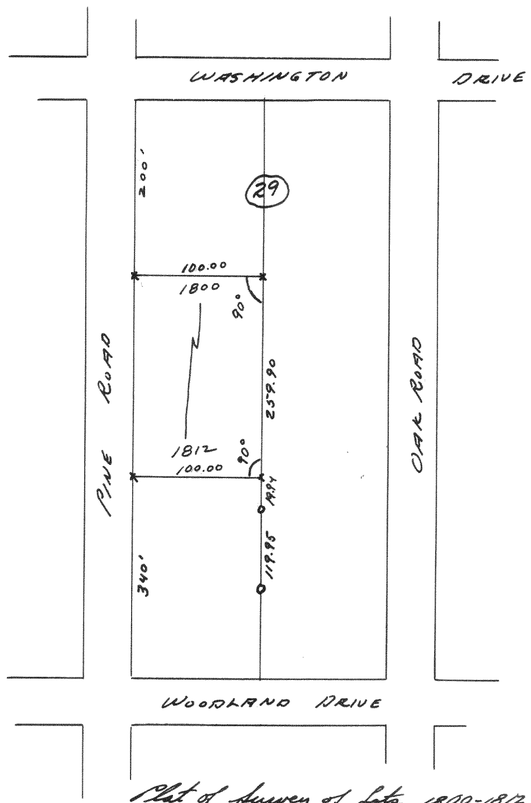


Plat of Survey of Lots 1800-1812 (INCL)
Block 29 Lake Como Beach Sub.
Oct. 1953 LLJ CS

2707

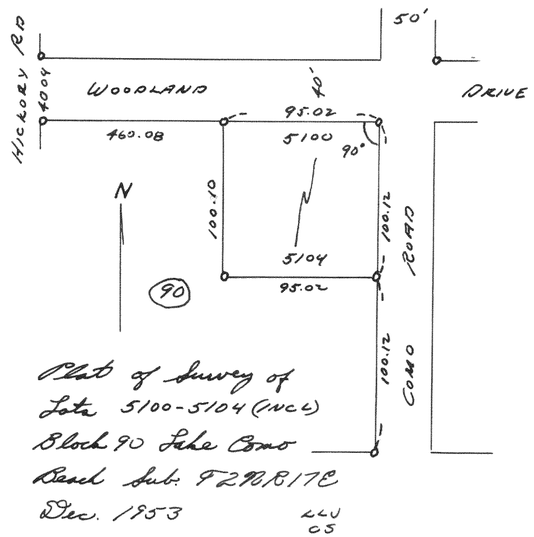


Plat of Survey of
Lots 5100-5104 (INCL)
Block 90 Lake Como
Beach Sub. T29NR17E
Dec. 1953 LLJ CS

2708

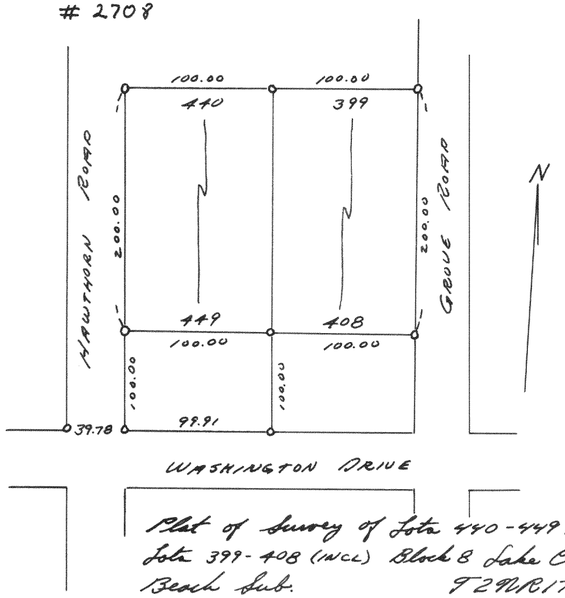

Plat of Survey of Lots 440-449 (INCL)
Lots 399-408 (INCL) Block 8 Lake Como
Beach Sub. T29NR17E
Aug. 1953 LLJ CS

2709

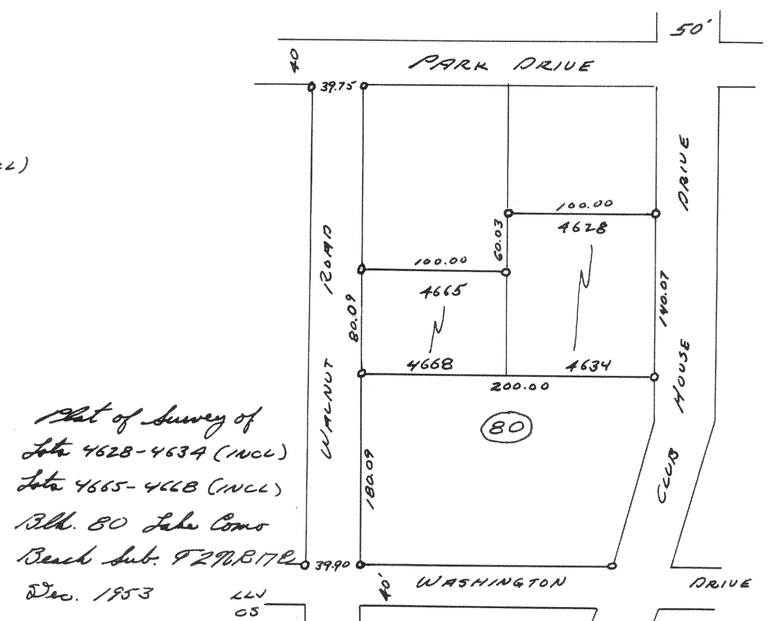

Plat of Survey of
Lots 4628-4634 (INCL)
Lots 4665-4668 (INCL)
Blk. 80 Lake Como
Beach Sub. T29NR17E
Dec. 1953 LLJ CS