

#3769

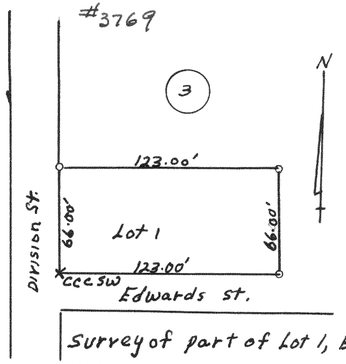

Survey of part of Lot 1, Blk 3 Edwards Add. to Vil. of East Troy, Wal. Co. Wisc.

Lloyd L. Jensen
County Surveyor


#3770

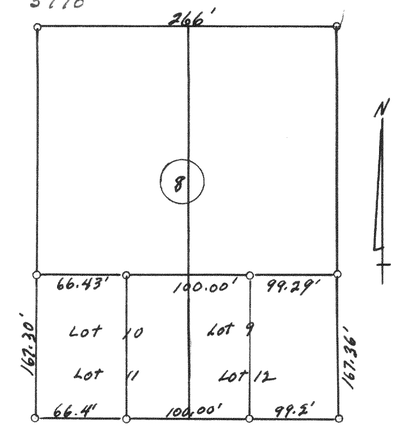

Survey of Block 8, O.P. of City of Elkhorn, Wal. Co. Wisc.

Lloyd L. Jensen
County Surveyor


#3771

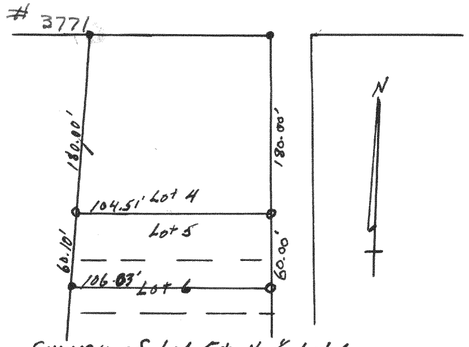

Survey of Lot 5 + N. ½ Lot 6, D.A. Reids Add to Reids Park, Vil. of Fontana, Wal. Co. Wisc.

Lloyd L. Jensen
County Surveyor


#3772

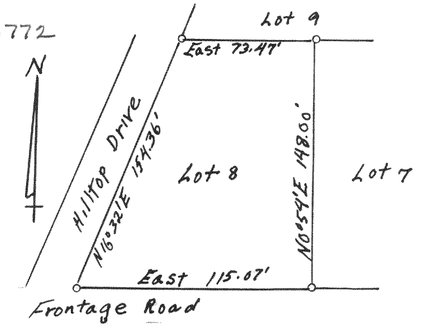

Survey of Lot 8, Lynndale Subd. Vil. of East Troy, Wal. Co. Wisc.

Lloyd L. Jensen
County Surveyor


#3773

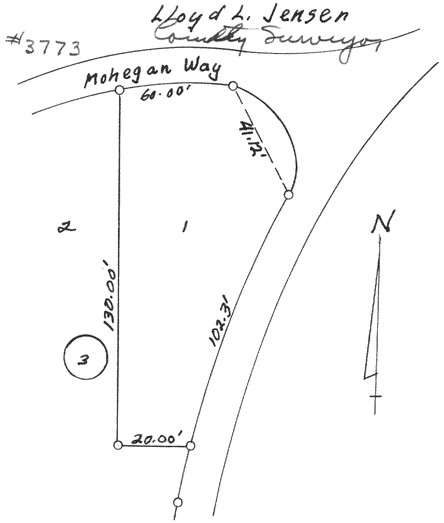

Survey of Lot 1, Blk 3, Indian Hills 1st Add to Vil. of Fontana, Wal. Co. Wisc.

Lloyd L. Jensen
County Surveyor


#3774

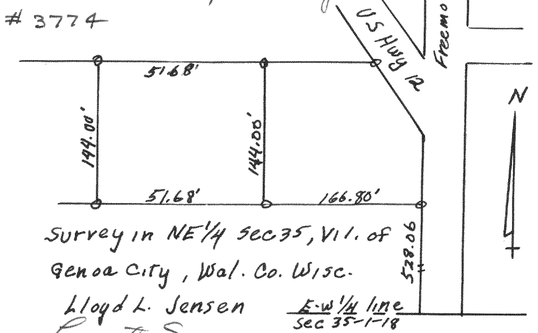

Survey in NE 1/4 Sec 35, Vil. of Genoa City, Wal. Co. Wisc.

Lloyd L. Jensen
County Surveyor


#3775

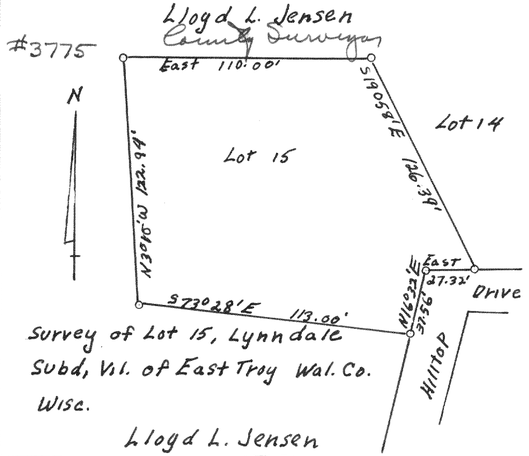

Survey of Lot 15, Lynndale Subd, Vil. of East Troy Wal. Co. Wisc.

Lloyd L. Jensen


#3776

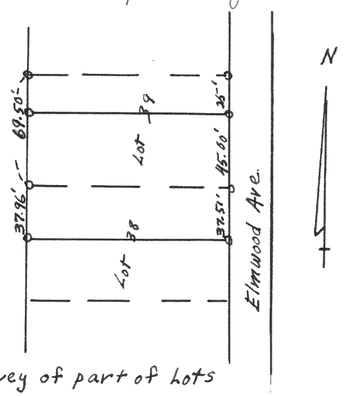

Survey of part of Lots 38+39, Sturwood Addition City of Lake Geneva, Wal. Co. Wisc.

Lloyd L. Jensen
County Surveyor

#3777

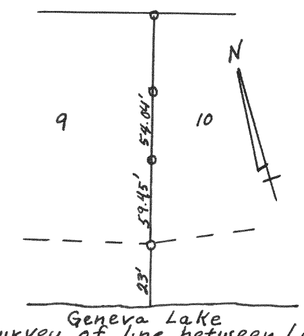

Survey of line between Lots 9+10 Ceylon Court, Sec 1, T1N, R17E, Wal. Co. Wisc.

Lloyd L. Jensen
County Surveyor