

#3794

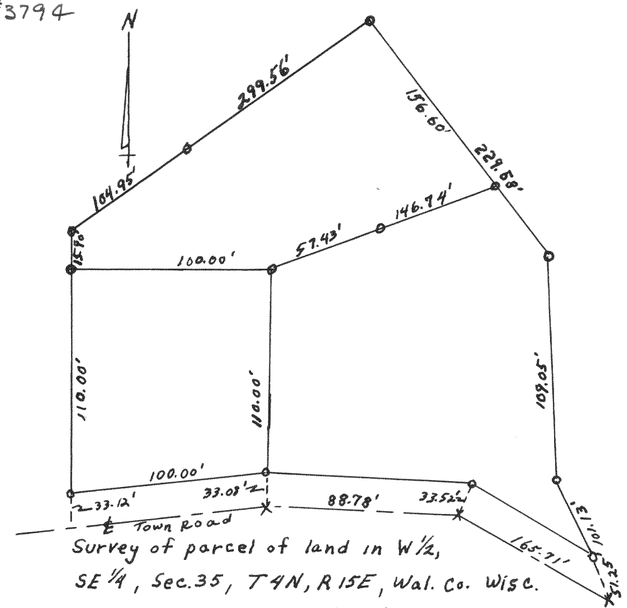

Survey of parcel of land in W½, SE¼, Sec. 35, T4N, R15E, Wal. Co. Wisc.

Lloyd L. Jensen
County Surveyor


#3795

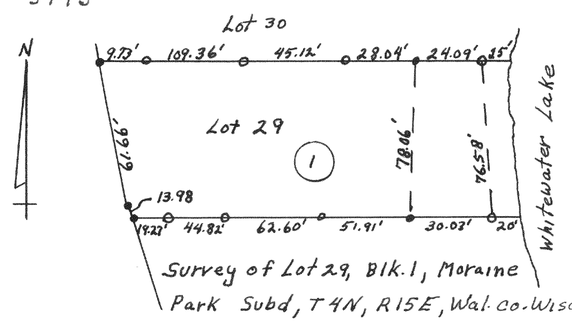

Survey of Lot 29, Blk. 1, Moraine Park Subd, T4N, R15E, Wal. Co. Wisc.


Lloyd L. Jensen
Lloyd L Jensen

#3796

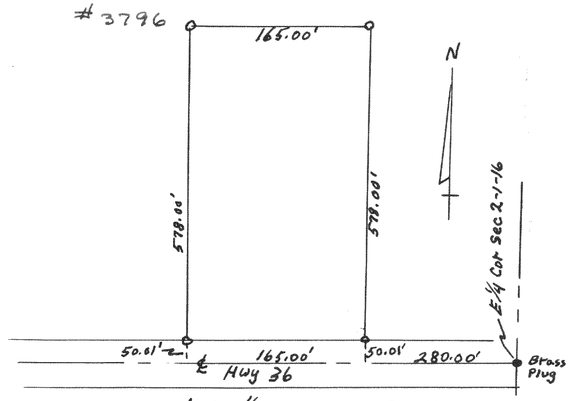

Survey in SE¼ NE¼ Sec 2, T1N, R16E, Wal. Co. Wisc.

#3797

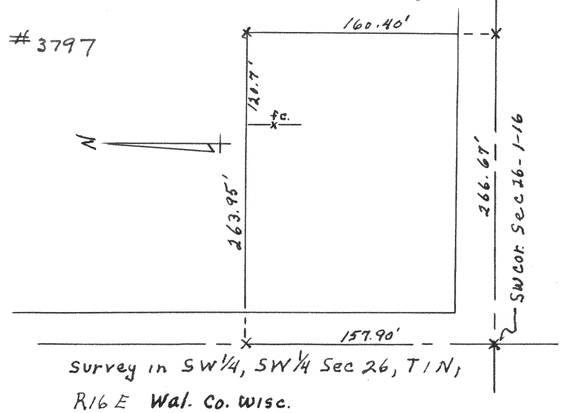


Survey in SW¼, SW¼ Sec 26, T1N, R16E Wal. Co. Wisc.

Lloyd L. Jensen
County Surveyor

#3798


Lloyd L. Jensen
County Surveyor

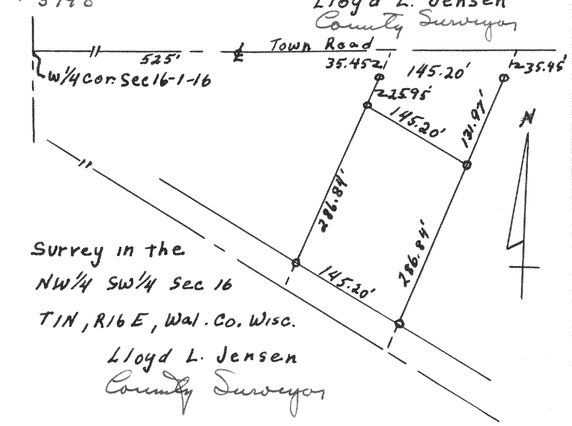

Survey in the NW¼ SW¼ Sec 16 T1N, R16E, Wal. Co. Wisc.

Lloyd L. Jensen
County Surveyor


#3799

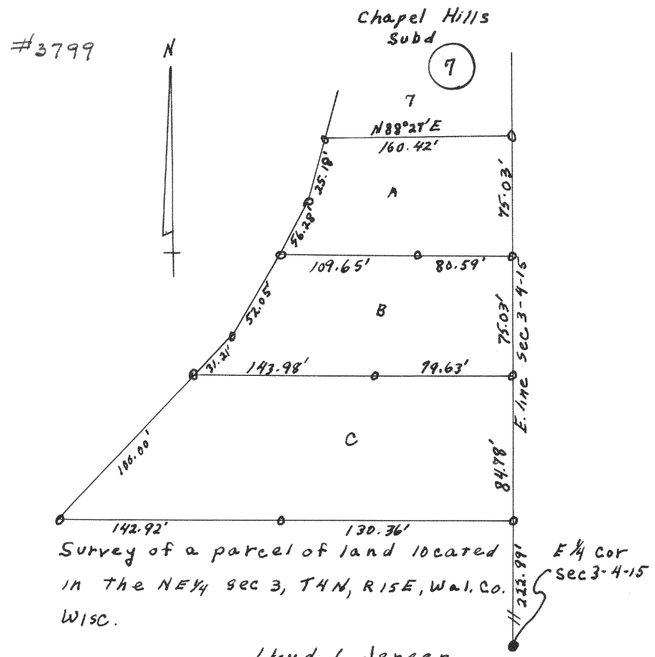

Survey of a parcel of land located in the NE¼ Sec 3, T4N, R15E, Wal. Co. Wisc.

Lloyd L. Jensen


#3800

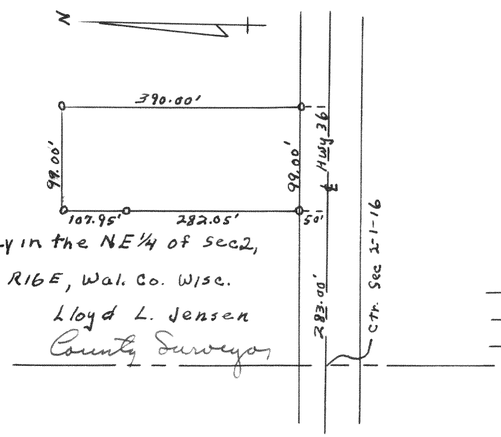

Survey in the NE¼ of Sec 2, T1N, R16E, Wal. Co. Wisc.

Lloyd L. Jensen
County Surveyor

#3801

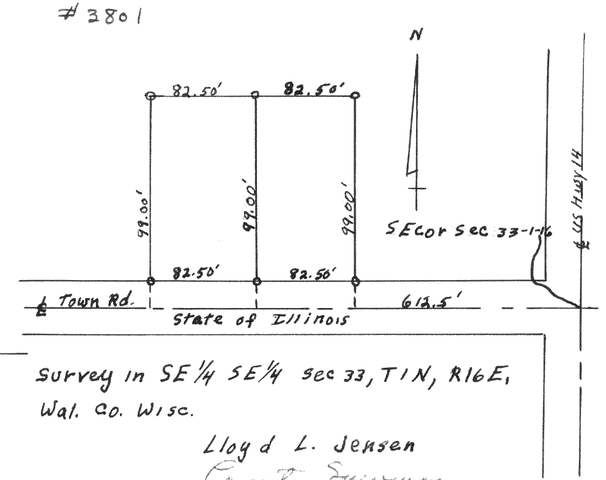

Survey in SE¼ SE¼ Sec 33, T1N, R16E, Wal. Co. Wisc.

Lloyd L. Jensen
County Surveyor