
#3809

PLAT OF SURVEY OF

LOT 11, TONY AND JULIA PETERS ADDITION TO THE CITY OF LAKE GENEVA, WALWORTH COUNTY, WISCONSIN.

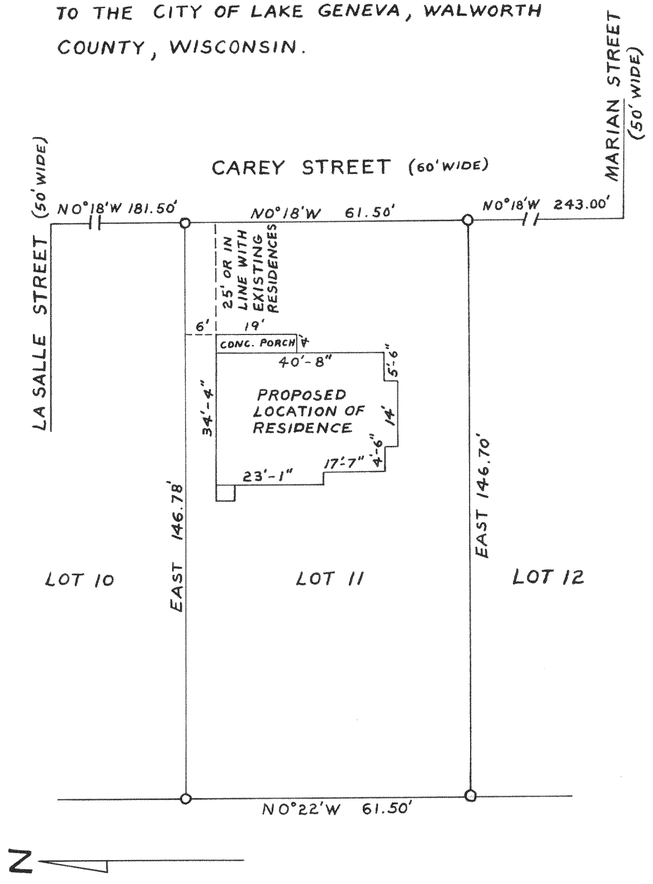


JUNE, 1960

Floyd L. Jensen
COUNTY SURVEYOR

#3810

PLAT OF SURVEY OF

LOT 8, BLOCK 15, LAKE GENEVA MANOR, LOCATED IN THE SE 1/4 SECTION 35, T2N, R17E, CITY OF LAKE GENEVA, WALWORTH COUNTY, WISCONSIN.

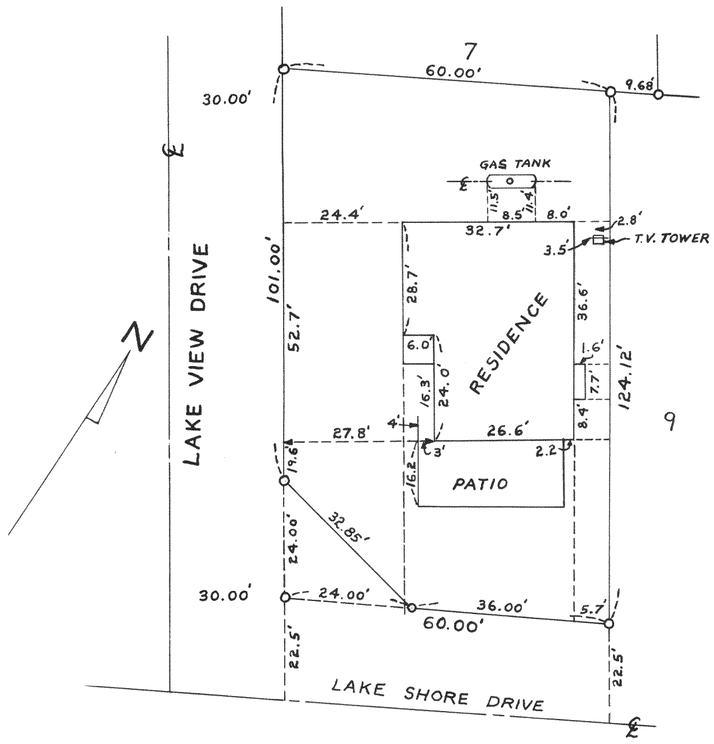


JULY 14, 1960

Floyd L. Jensen
COUNTY SURVEYOR

#3811

PLAT OF SURVEY OF

PART OF LOTS 5 AND 6, BLOCK 13, ORIGINAL PLAT OF THE CITY OF LAKE GENEVA, WALWORTH COUNTY, WISCONSIN.

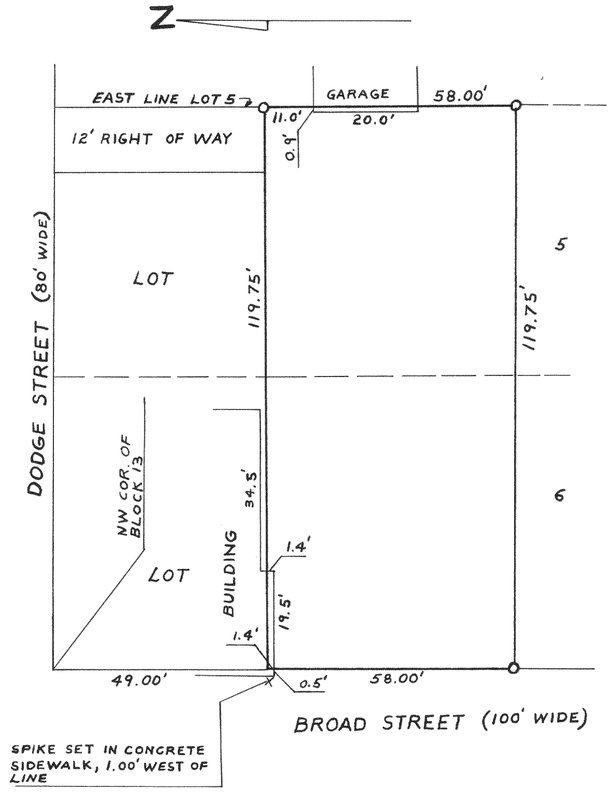

APRIL, 1960

Floyd L. Jensen
COUNTY SURVEYOR