
#3812

PLAT OF SURVEY OF

LOTS 12 AND 13 AND PART OF LOT 11, THE GARDENS, LOCATED IN THE VILLAGE OF FONTANA - ON - GENEVA LAKE, WALWORTH COUNTY, WISCONSIN.

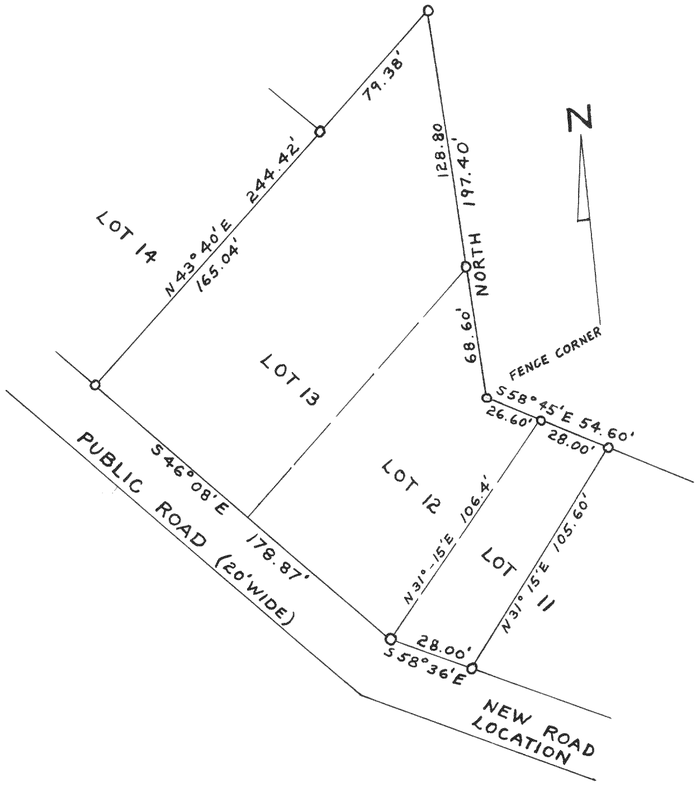


JUNE, 1960

Floyd L Jensen
COUNTY SURVEYOR

#3813

PLAT OF SURVEY OF

LOT 4, BLOCK 4, WHEELER'S SUBDIVISION CITY OF LAKE GENEVA, WALWORTH COUNTY, WISCONSIN.

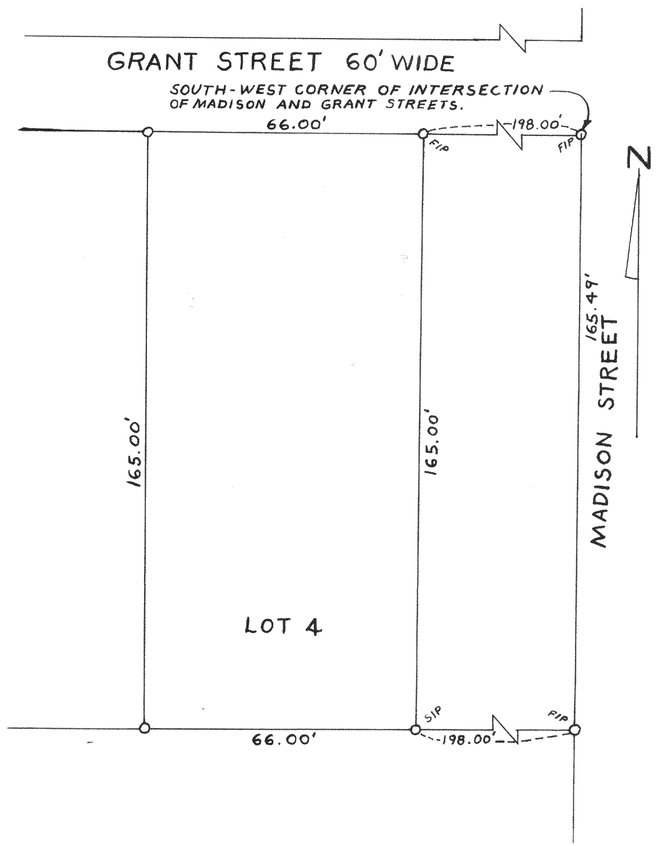


FEBRUARY, 1960

Floyd L Jensen
COUNTY SURVEYOR

#3814

PLAT OF SURVEY OF

A PARCEL OF LAND LOCATED IN THE SOUTH ½ OF THE NORTH ½ OF THE NORTHEAST ¼ OF SECTION 35, T1N, R18E, VILLAGE OF GENOA CITY, WALWORTH COUNTY, WISCONSIN.

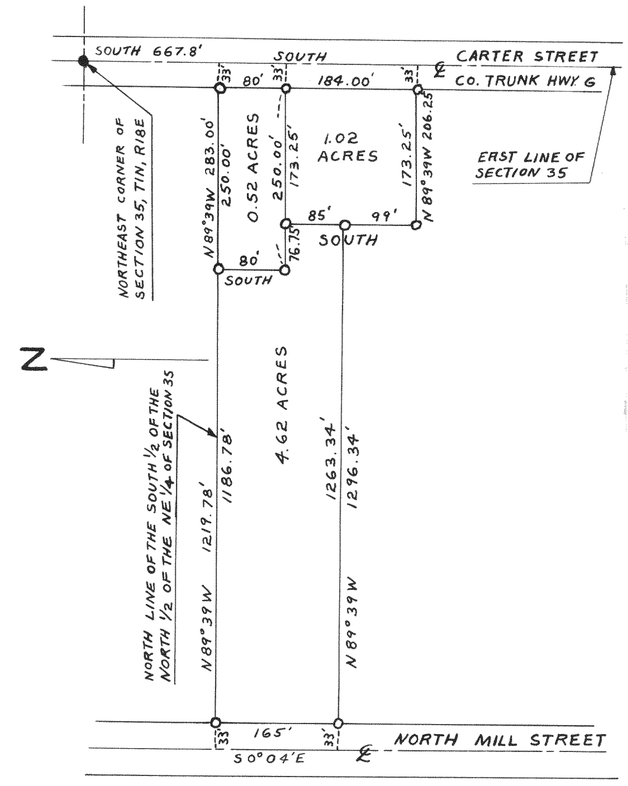

JANUARY, 1961

Floyd L. Jensen
COUNTY SURVEYOR