

#3821

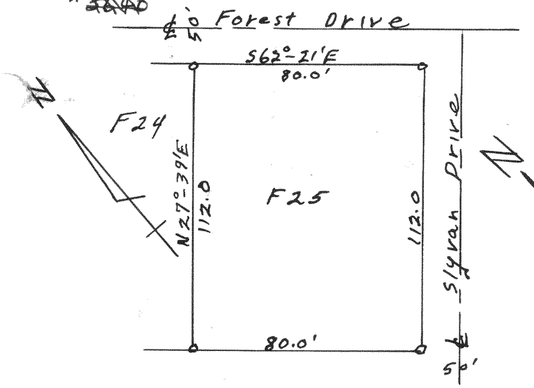


Plat of survey of F25 add F to Country Club Estates, Village of Fontana, Walworth County Wisconsin Lloyd L. Jensen July 1959 County Surveyor

#3822

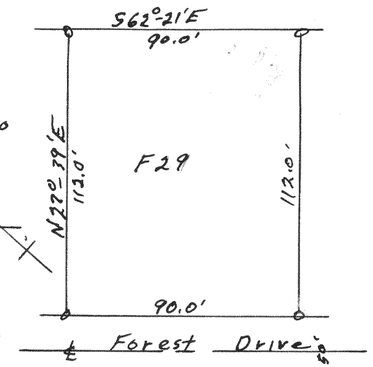


Plat of survey of Lot 29 add F to Country Club Estates, Village of Fontana, Walworth County Wisconsin July 1959 Lloyd L. Jensen County Surveyor

#3823

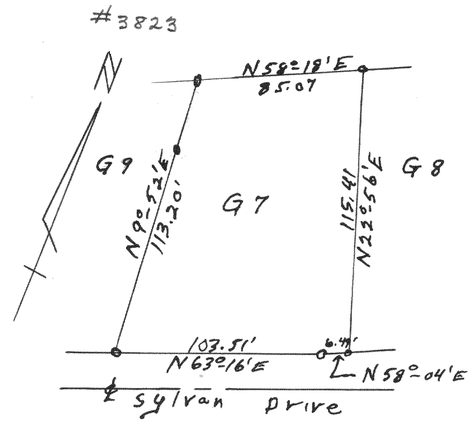


Plat of survey of Lot G-7 Add. G to Country Club Estates, Village of Fontana, Walworth County Wisconsin. sept. 1959 Lloyd L. Jensen County Surveyor

#3826

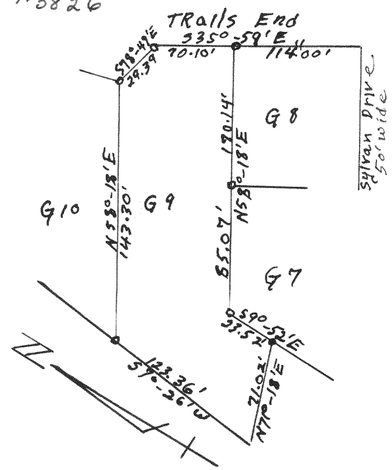


Plat of survey of Lot G-9 Add. G to Country Club Estates, Village of Fontana, Walworth County Wisconsin. Oct. 1959 Lloyd L. Jensen County Surveyor

#3824

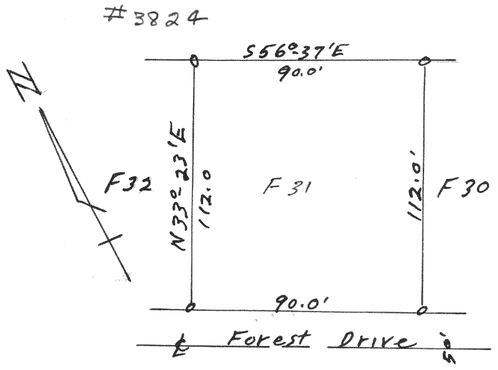


Plat of survey of Lot F31 add. F to Country Club Estates Village of Fontana, Walworth County Wisconsin Lloyd L. Jensen July 1959 County Surveyor

#3825

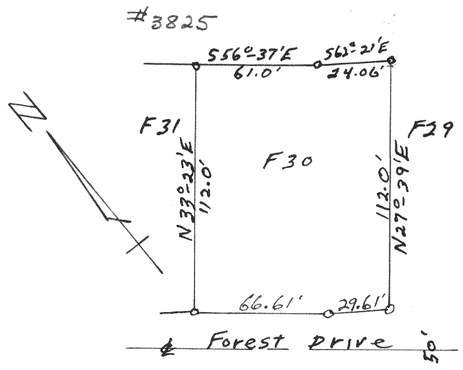

Plat of survey of Lot F-30 Add. F to Country Club Estates, Village of Fontana, Walworth County, Wisconsin Sept. 1959 Lloyd L. Jensen County Surveyor

#3827

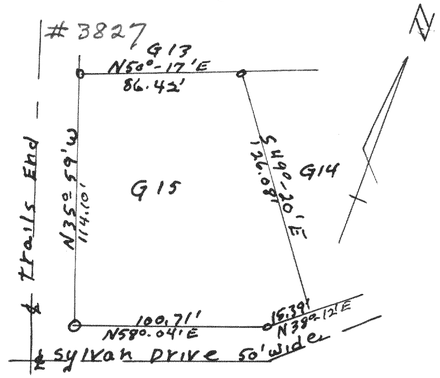

Plat of survey of Lot G15 Add. G to Country Club Estates, Village of Fontana, Walworth County Wisconsin. Oct 1959 Lloyd L. Jensen County Surveyor