
#3838

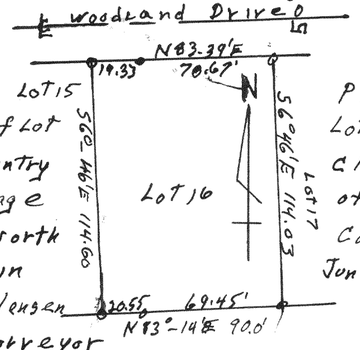


Plat of survey of Lot 16 add. E To Country Club Estates, Village of Fontana, Walworth County Wisconsin June Lloyd L Jensen 1959 County Surveyor

#3839




Plat of Survey of Lot 118, Unit 2 Country Club Estates Village of Fontana, Walworth County Wisconsin June 1959 Lloyd L. Jensen County Surveyor

#3840

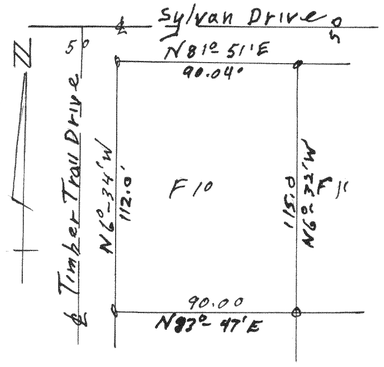


Plat of survey of Lot F10 add. F. to country Club Estates Village of Fontana, Walworth County Wisconsin May 1959 Lloyd L Jensen County Surveyor

#3841

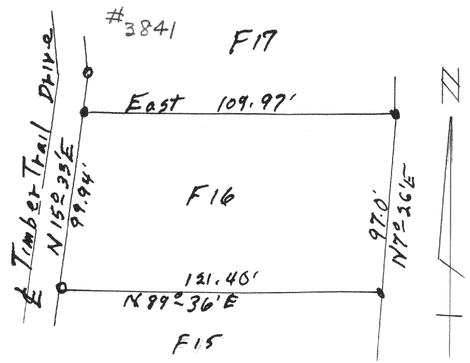


Plat of survey of Lot F16 Add F to Country Club Estates, Village of Fontana, Walworth County Wisconsin Lloyd L Jensen County Surveyor

#3842

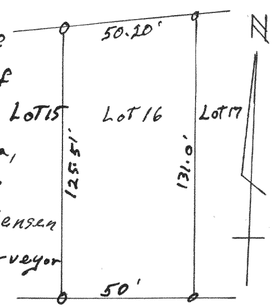


Plat of Survey of Lot 16 Block 5 of Indian Hills Subd. Lot 15 Village of Fontana, Walworth County Wisconsin Lloyd L. Jensen June 1959 County Surveyor

#3843

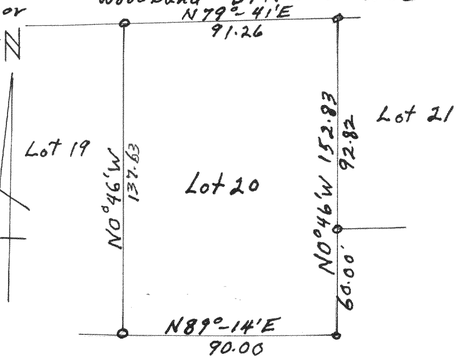


Plat of Survey of Lot 20, add. E To Country Club Estates, Village of Fontana, Walworth County, Wisconsin Mar. Lloyd L. Jensen 1959 County Surveyor

#3844

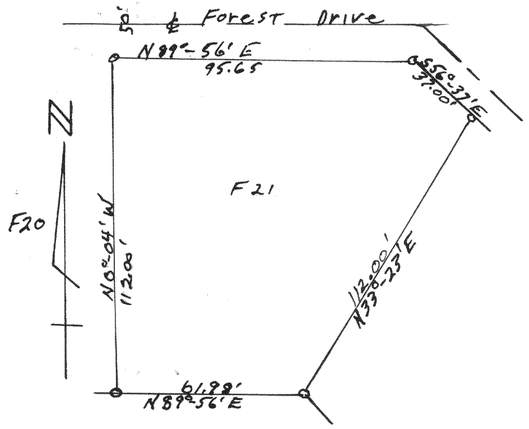

Plat of survey of Lot F21 Add. F to country Club Estates, Village of Fontana, Walworth county Wisconsin NOV. 1959 Lloyd L. Jensen County surveyor

#3845

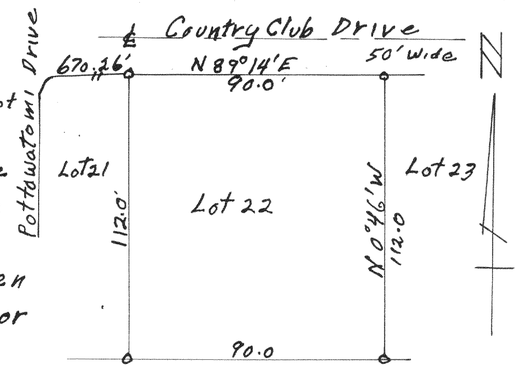

Plat of survey of Lot 22, add E to Country Club Estates, Village of Fontana, Walworth County Wisconsin April Lloyd L. Jensen 1959 County Surveyor