#3850

Plat of survey of Part of Lot 2, Block 5 Arnolds Addition to the City of Elkhorn Walworth County Wisconsin Lloyd L. Jensen July 1959 County Surveyor

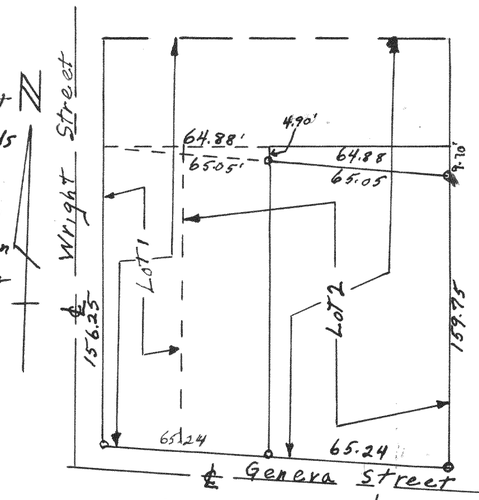

#3851

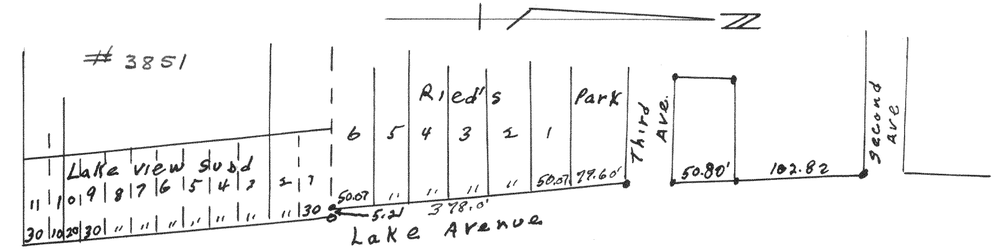

Plat of survey of ~~North~~ West side of Lake Avenue, Fontana Walworth County Wisconsin Lloyd L. Jensen County Surveyor

#3853

Plat of survey of Lot 3 Block E Unit 3 of Country Club Estates, located in the Village of Fontana Walworth County Wisconsin Lloyd L. Jensen Dec. 1958 County Surveyor

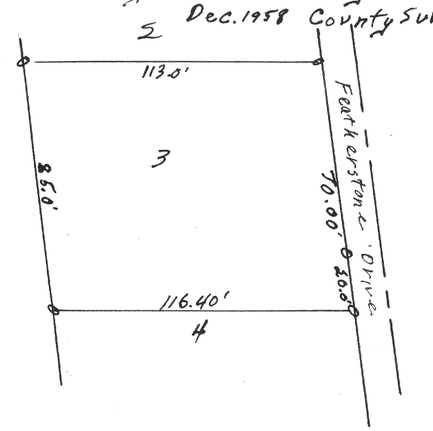

#3852

Plat of survey of Lot 9 Block E Unit 3 to Country Club Estates Village of Fontana Walworth County Wisconsin Lloyd L. Jensen April 1959 County Surveyor

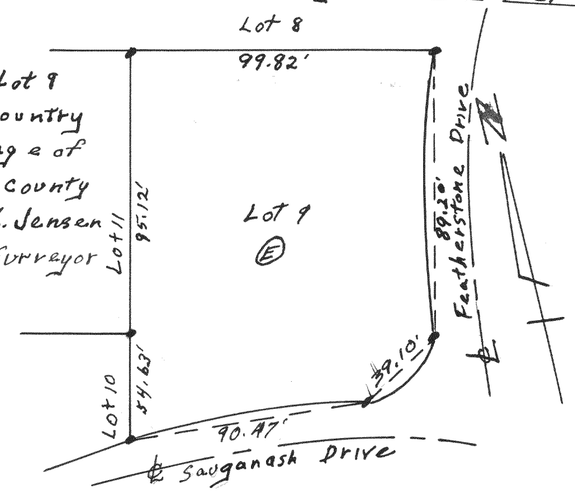

#3854

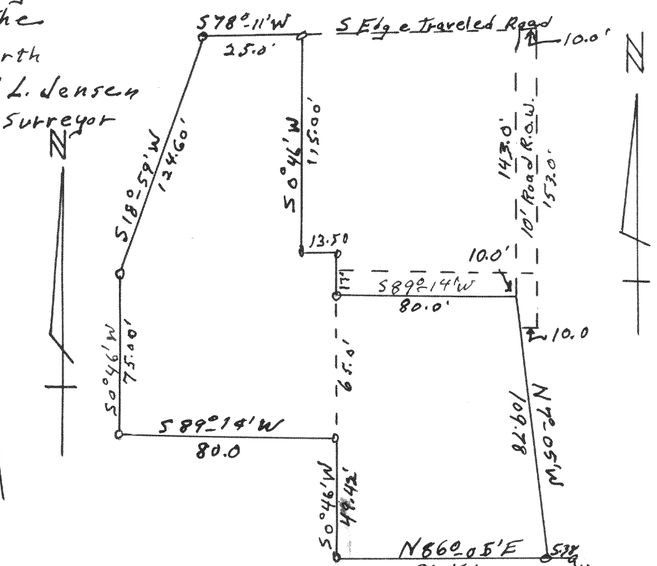

Plat of survey of Land in NW Fr. 1/4 of Sec. 13 T1N, R16E Walworth County Wisconsin Sep 1959 Lloyd L. Jensen County Surveyor Middle 1/4 section of Section 13, T1N, R16E