

#3869

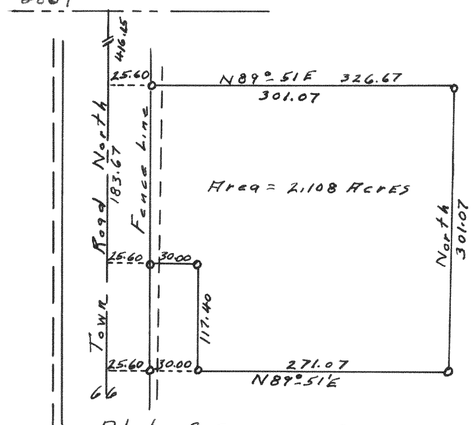


Plat of Survey of Land
in the SE 1/4 of Sec. 32
T1N R15E Walworth
County Wisconsin
May. 1959 Lloyd L. Jensen
County Surveyor

#3870

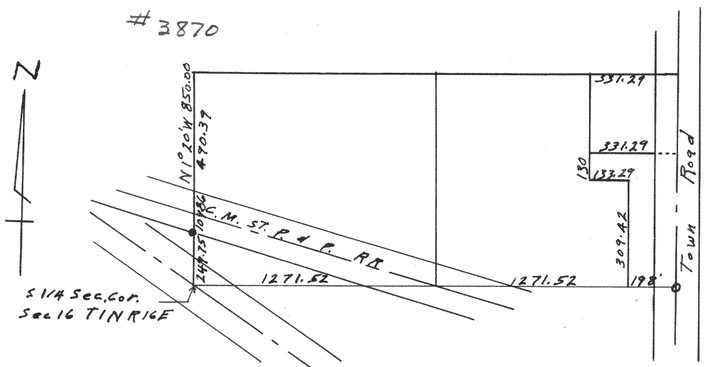


Plat of Survey of Land
Located in the SE 1/4 of
Sec. 16, T1N R16E
Walworth County Wisconsin
Lloyd L. Jensen
County Surveyor

#3871

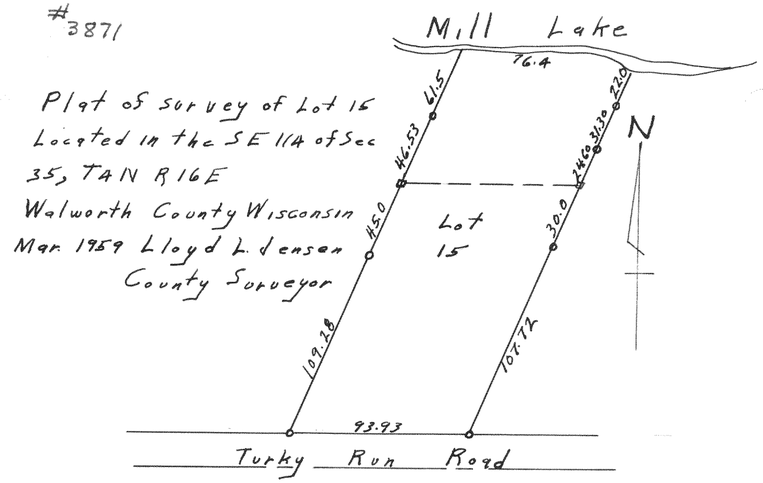


Plat of survey of Lot 15
Located in the SE 1/4 of Sec
35, T4N R16E
Walworth County Wisconsin
Mar. 1959 Lloyd L. Jensen
County Surveyor

#3872

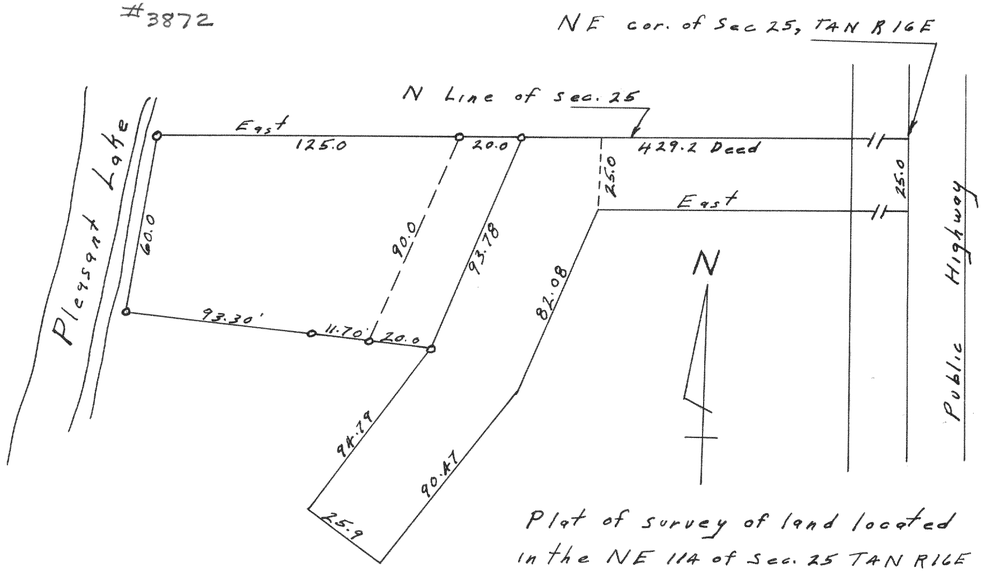

Plat of survey of land located
in the NE 1/4 of Sec. 25 T4N R16E
Walworth County Wisconsin
June 1959 Lloyd L. Jensen
County Surveyor

#3873

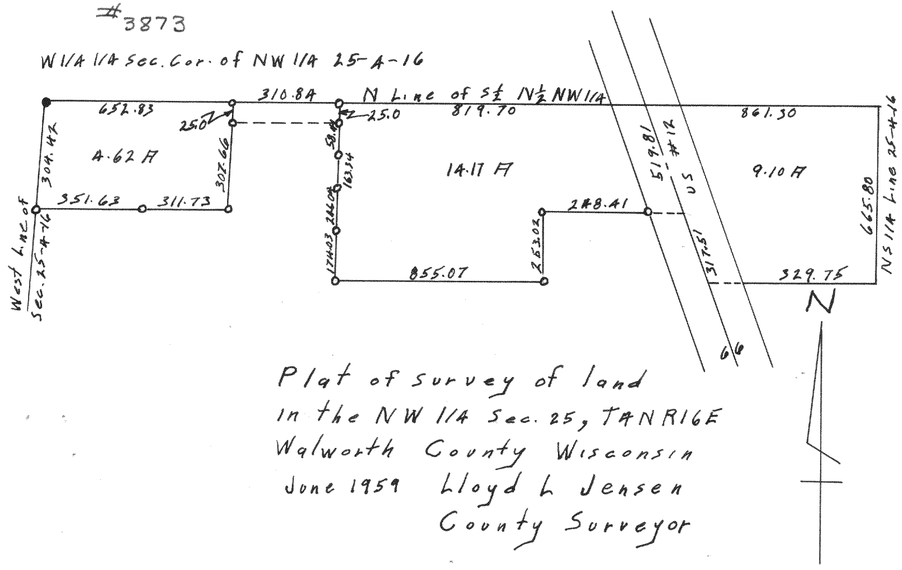

Plat of survey of land
in the NW 1/4 Sec. 25, T4N R16E
Walworth County Wisconsin
June 1959 Lloyd L Jensen
County Surveyor