

2716

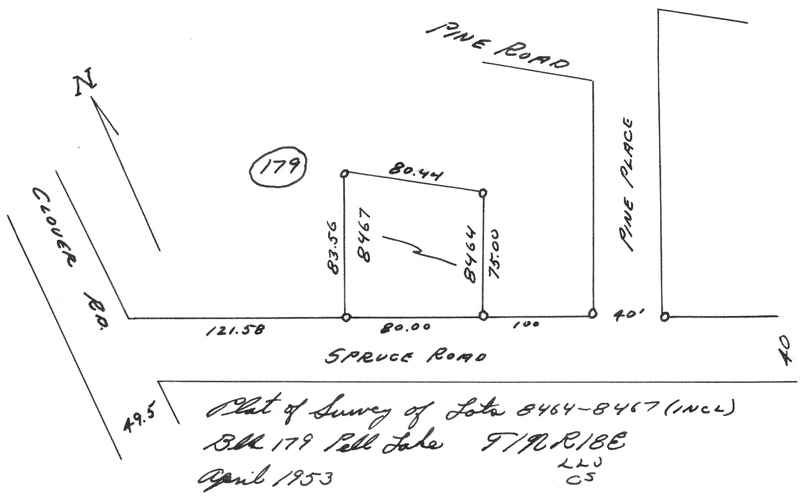


Plat of Survey of Lots 8464-8467 (INCL)
Blk 179 Pell Lake T19N R18E
April 1953
LLJ
CS

2717

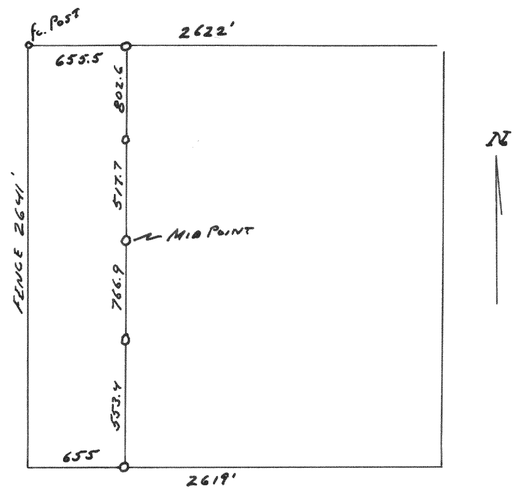


Plat of Survey of West 40 Acres
of NW¼ Section 21 T19N R18E
March 1953
LLJ
CS

2718

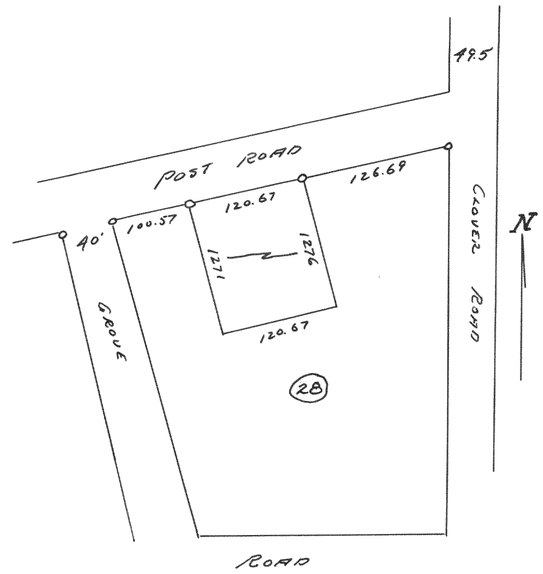


Plat of Survey of Lots
1271-1276 (INCL) Blk. 28
Pell Lake T19N R18E
June 1953
LLJ
CS

2719

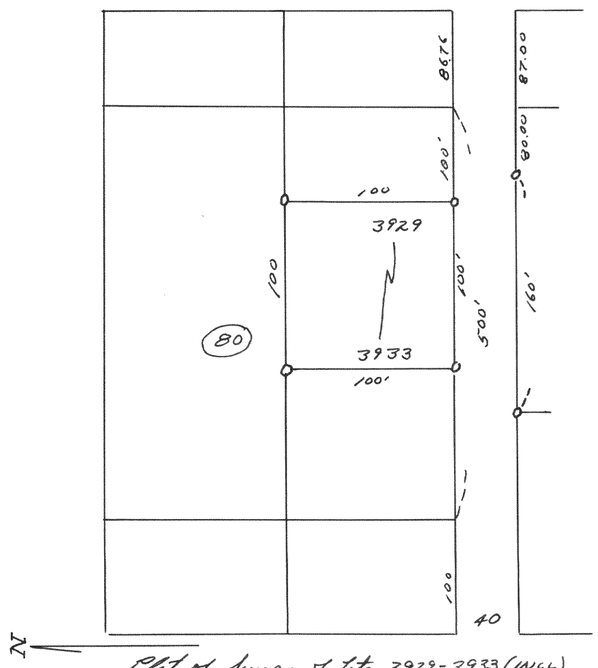


Plat of Survey of Lots 3929-3933 (INCL)
Blk 80 Pell Lake T19N R18E
March 1953
LLJ
CS

2720

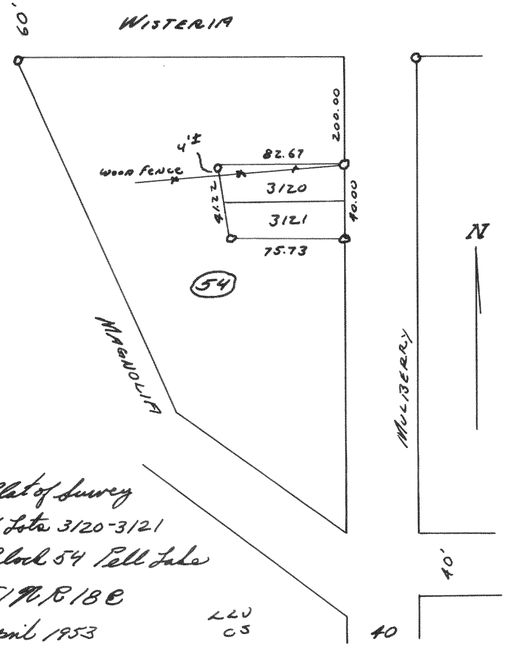

Plat of Survey
of Lots 3120-3121
Block 54 Pell Lake
T19N R18E
April 1953
LLJ
CS

2721

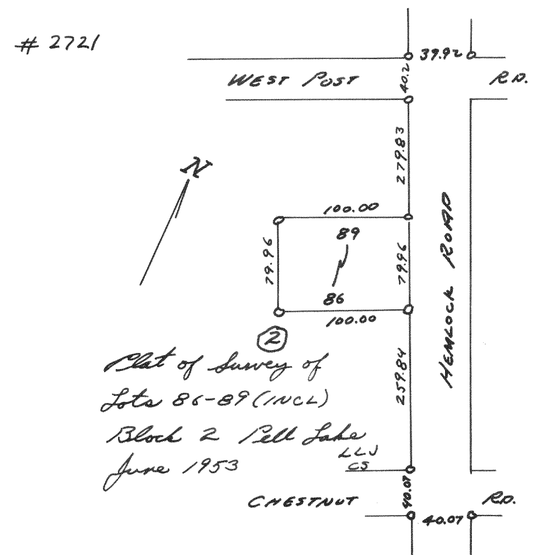

Plat of Survey of
Lots 86-89 (INCL)
Block 2 Pell Lake
June 1953
LLJ
CS