

#3885

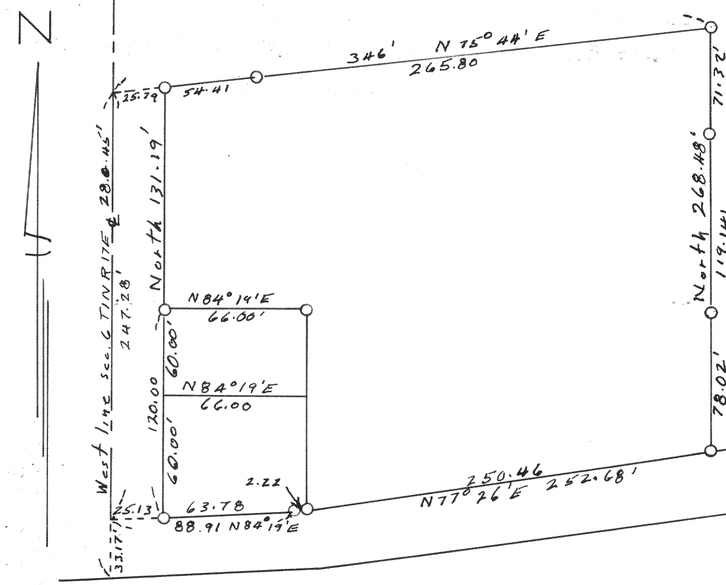

Plat of survey of Lands owned by the Hollister Lumber Co in the NW 1/4 of Section 6, T1N, R17E in the Village of Williams Bay, Walworth County Wisconsin Nov 1960

Lloyd L. Jensen
County Surveyor


#3886

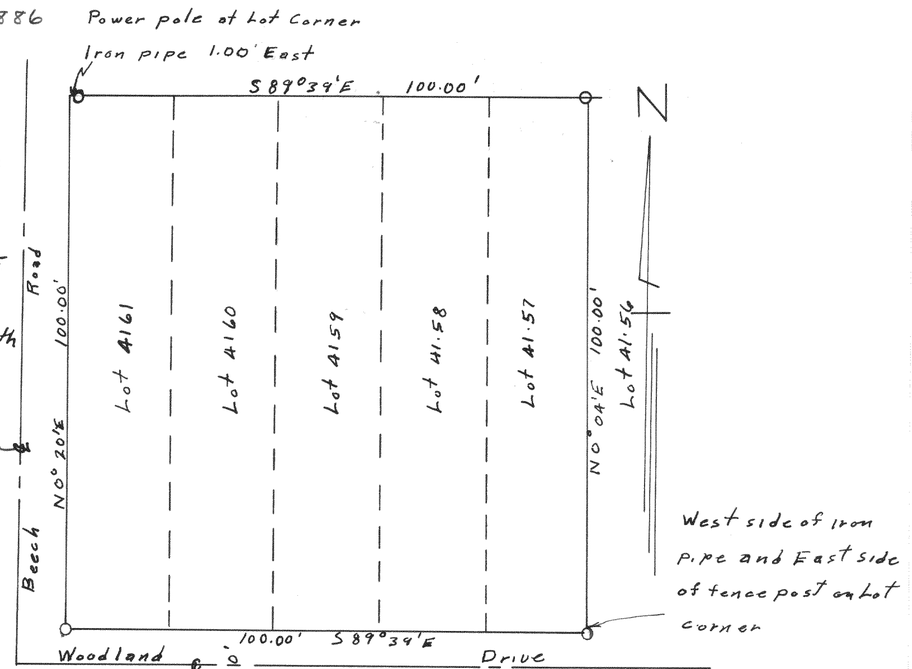

Plat of survey of Lots 4157 To 4161, Block 71 Lake Como Beach, located in the NE 1/4 of Section 27, T2N R17E, Walworth County Wisconsin Feb. 1961

Lloyd L Jensen
County Surveyor


#3887

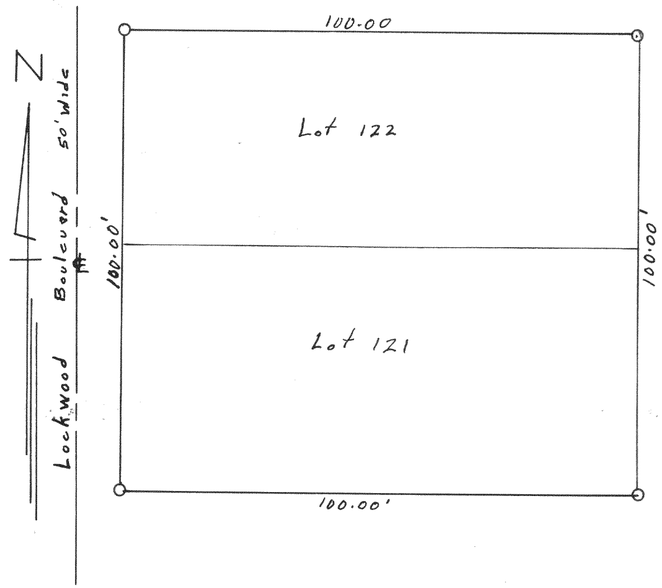

Plat of survey of Lots 121 and 122 Lake Geneva Golf Hills Subd. located in Section 31, T2N R18E of Walworth County Wisconsin Feb. 1961

Lloyd L. Jensen
County Surveyor

#3888

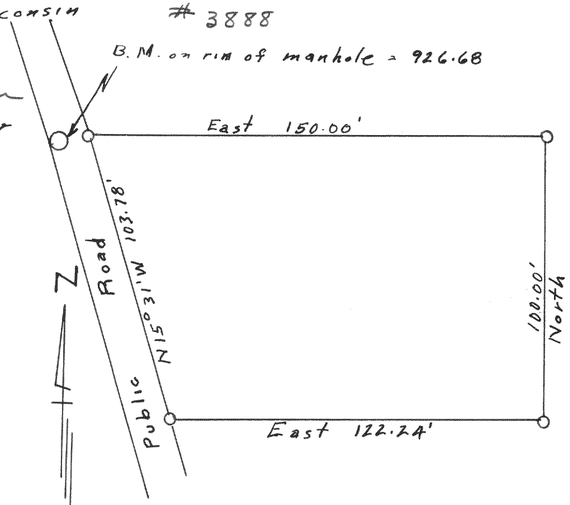

Plat of survey of part of outlot 88, Located in the SE 1/4 of the SE 1/4 of Section 14, T1N, R16E Village of Fontana-on Geneva Lake, Walworth County Wisconsin Feb. 1961

Lloyd L Jensen
County Surveyor