
#3916

PLAT OF SURVEY OF

LOTS 545-549 INCLUSIVE, IN SECTION 16, BLOCK 16, IN PELL LAKE SUBDIVISION, BLOOMFIELD TOWNSHIP, WALWORTH COUNTY, WISCONSIN.

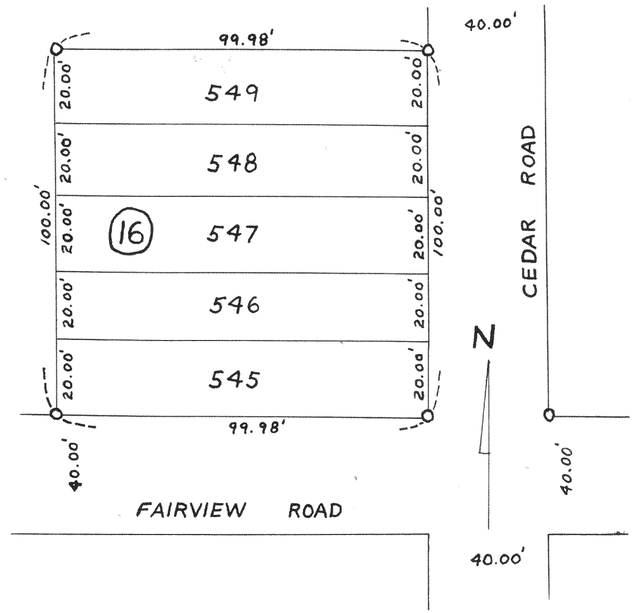


JANUARY 18, 1961

Floyd L Jensen
COUNTY SURVEYOR

#3917

PLAT OF SURVEY OF

LOTS 4950, 4951 AND 4952, OF BLOCK 94, OF PELL LAKE SUBDIVISION, SECTION 3, LOCATED IN BLOOMFIELD TOWNSHIP, WALWORTH COUNTY, WISCONSIN.

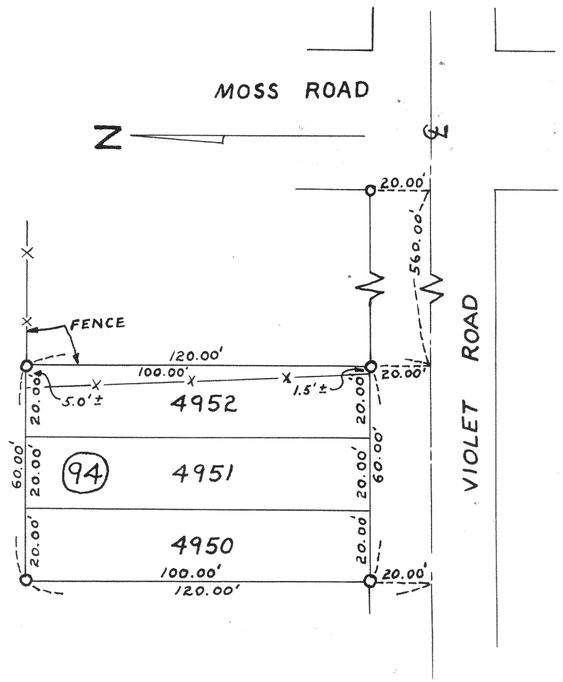


JANUARY 18, 1961

Floyd L Jensen
COUNTY SURVEYOR

#3918

PLAT OF SURVEY OF

LOTS 95, 96, 97, 98 AND 99, BLOCK 2, PELL LAKE ADDITION, LOCATED IN THE W½ OF THE SW¼ SECTION 14, AND THE N½ OF THE NW¼ OF SECTION 23, TOWN 1, NORTH RANCE 18 EAST, BLOOMFIELD TOWNSHIP, WALWORTH COUNTY, WISCONSIN.

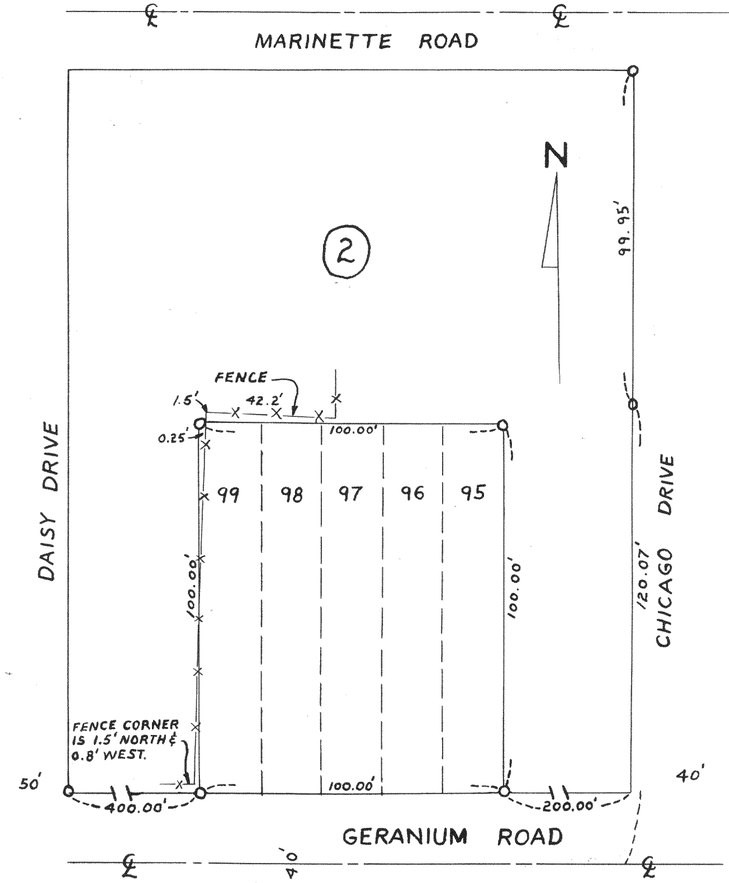

JUNE, 17, 1960

Floyd L Jensen
COUNTY SURVEYOR